

THE TOWN OF ARLINGTON

SEWER DEPARTMENT

Side Section Plat
(PREPARE IN DUPLICATE)

Permit No. 435

Owner's Name Basil Davis


Address of Property 4th & West

Owner's Mailing Address ~~Howard Park~~ Route #1 Arlington

Side Sewer Contractor

Legal Description of Premises 2-31-5 Beg 300' N of SW Cor SW 1/4 SE 1/4

TA 1100' TH E To W Bay NP RW TH SW Aly SD RW To Pt E of P&B W to P&B

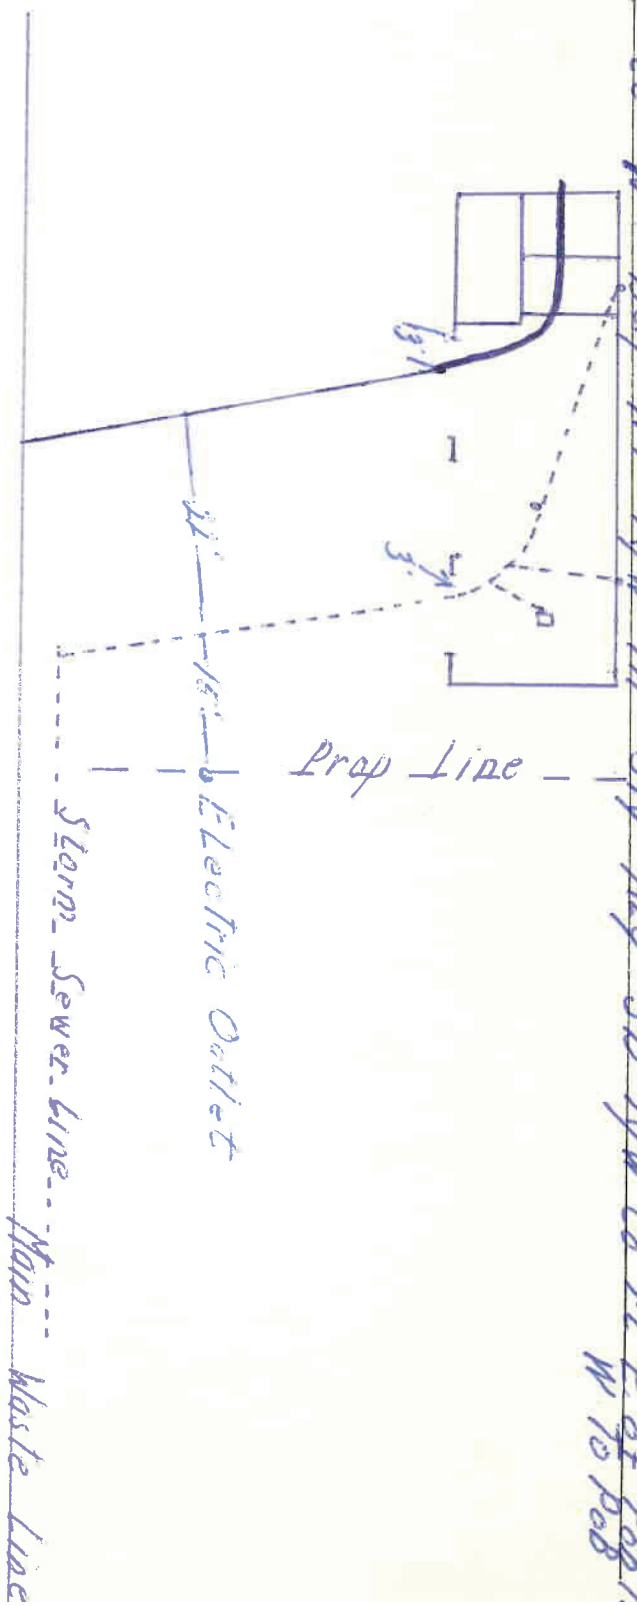

Union 76 STATION

With Good # 10855

3900.0
~~03.900.0~~

- 1. Commercial Single Residence
- 2. Distance from property line to sewer line
- 3. Distance from house building line to property line
- 4. Min. grade from main to property line From property line to bldg. 1/2"
- 5. Distance from M. H. No.
- 6. Depth: Sewer main
- 7. Basement Basement connection
- 8. Depth of pipe at house connection 3'
- 9. Type of pipe: Concrete Vitrified Clay Asbestos-Cement
- 10. Remarks:

COMMERCIAL ONLY

1. Name Howard Park

2. Type Sewer Station

3. Sq. Ft. Floor Space 1456

4. No. of Floors 1

5. Remarks:

SPECIAL AGREEMENTS

1. Grade Release

2. High Grade Release

3. Non-Protecting Agmt.

4. Easement

5. Permission to Connect

6. Special

I hereby certify that the above connection has been made as shown:

Inspector *[Signature]* Date 6/12/61

Date Permit Issued Permit No. 435