

# THE TOWN OF ARLINGTON

## SEWER DEPARTMENT


Side S, Plat  
(PREPARE IN DUPLICATE)

Permit No. 442

Owner's Name Calvin & Valerie Collier  
 Owner's Mailing Address Calvin & Valerie Collier, 201 W. Main St., Wash.  
 Legal Description of Premises Lot 25 Whoblistki Add'l. 7.04

Address of Property Calvin & Valerie Collier  
 Side Sewer Contractor Calvin & Valerie Collier  
 Mailing Address 201 W. Main St., Wash.  
402 Clara St

**FILE COPY**

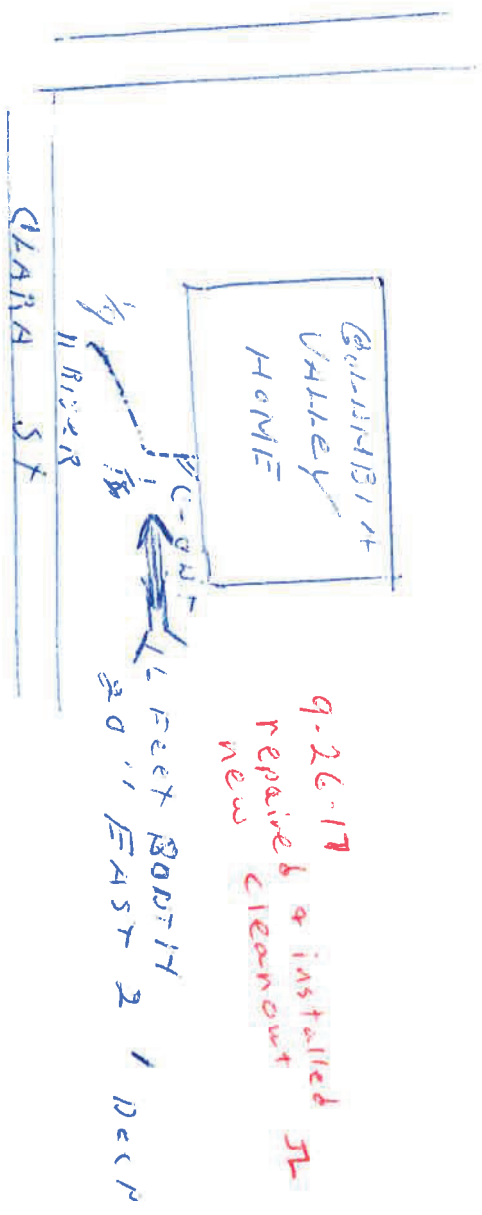

- 1. Commercial  Single Residence  Multiple Dwelling  Joint Use
- 2. Distance from property line to sewer line
- 3. Distance from house building line to property line          From property line to bldg.
- 4. Min. grade from main to property line
- 5. Distance from M. H. No.
- 6. Depth: Sewer main
- 7. Basement          Basement connection          (Reference to first floor)
- 8. Depth of pipe at house connection
- 9. Type of pipe: Concrete         , Vitrified Clay         , Asbestos-Cement         , Size
- 10. Remarks:

**COMMERCIAL ONLY**

**SPECIAL AGREEMENTS**

- 1. Name
- 2. Type
- 3. Sq. Ft. Floor Space
- 4. No. of Floors
- 5. Remarks:
- 1. Grade Release
- 2. High Grade Release
- 3. Non-Protecting Agmt.
- 4. Basement
- 5. Permission to Connect
- 6. Special

I hereby certify that the above connection has been made as shown:

Inspector          Date         

Date Permit Issued          Permit No.