

THE TOWN OF ARLINGTON


SEWER DEPARTMENT

Side Street Plat
(PREPARE IN DUPLICATE)

Permit No. 359

Owner's Name A. DeBenedictis
 Owner's Mailing Address 103 S. Pine Street
 Legal Description of Premises Lot 11-12-13

Address of Property 103 S. Pine Street
 Side Sewer Contractor Robert J. DeBenedictis
 Mailing Address 103 S. Pine Street

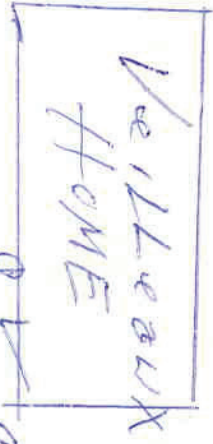

10-38000
0428000

- 1. Commercial..... Single Residence Multiple Dwelling..... Joint Use.....
- 2. Distance from property line to sewer line.....
- 3. Distance from house building line to property line..... From property line to bldg. 2 1/2
- 4. Min. grade from main to property line.....
- 5. Distance from M. H. No.
- 6. Depth: Sewer main.....
- 7. Basement..... Basement connection 110 (Reference to first floor)
- 8. Depth of pipe at house connection.....
- 9. Type of pipe: Concrete....., Vitrified Clay....., Asbestos-Cement....., Size 4 1/2
- 10. Remarks:

COMMERCIAL ONLY

- 1. Name
- 2. Type
- 3. Sq. Ft. Floor Space
- 4. No. of Floors
- 5. Remarks:

SPECIAL AGREEMENTS

- 1. Grade Release
- 2. High Grade Release
- 3. Non-Profiting Agmt.
- 4. Easement
- 5. Permission to Connect
- 6. Special

I hereby certify that the above connection has been made as shown:

Inspector Robert J. DeBenedictis Date 10/10/99
 Date Permit Issued..... Permit No. 359