

# THE TOWN OF ARLINGTON

## SEWER DEPARTMENT

Side Sewer Plat  
(PREPARE IN DUPLICATE)

Permit No. 557A

# 2990


Owner's Name Bernard Dreier

Owner's Mailing Address 405 E Third

Legal Description of Premises Plat Mahan's 1st Add to Arlington Lots 11-12-13

Side Sewer Contractor Pete Roal

Mailing Address 405 E Third

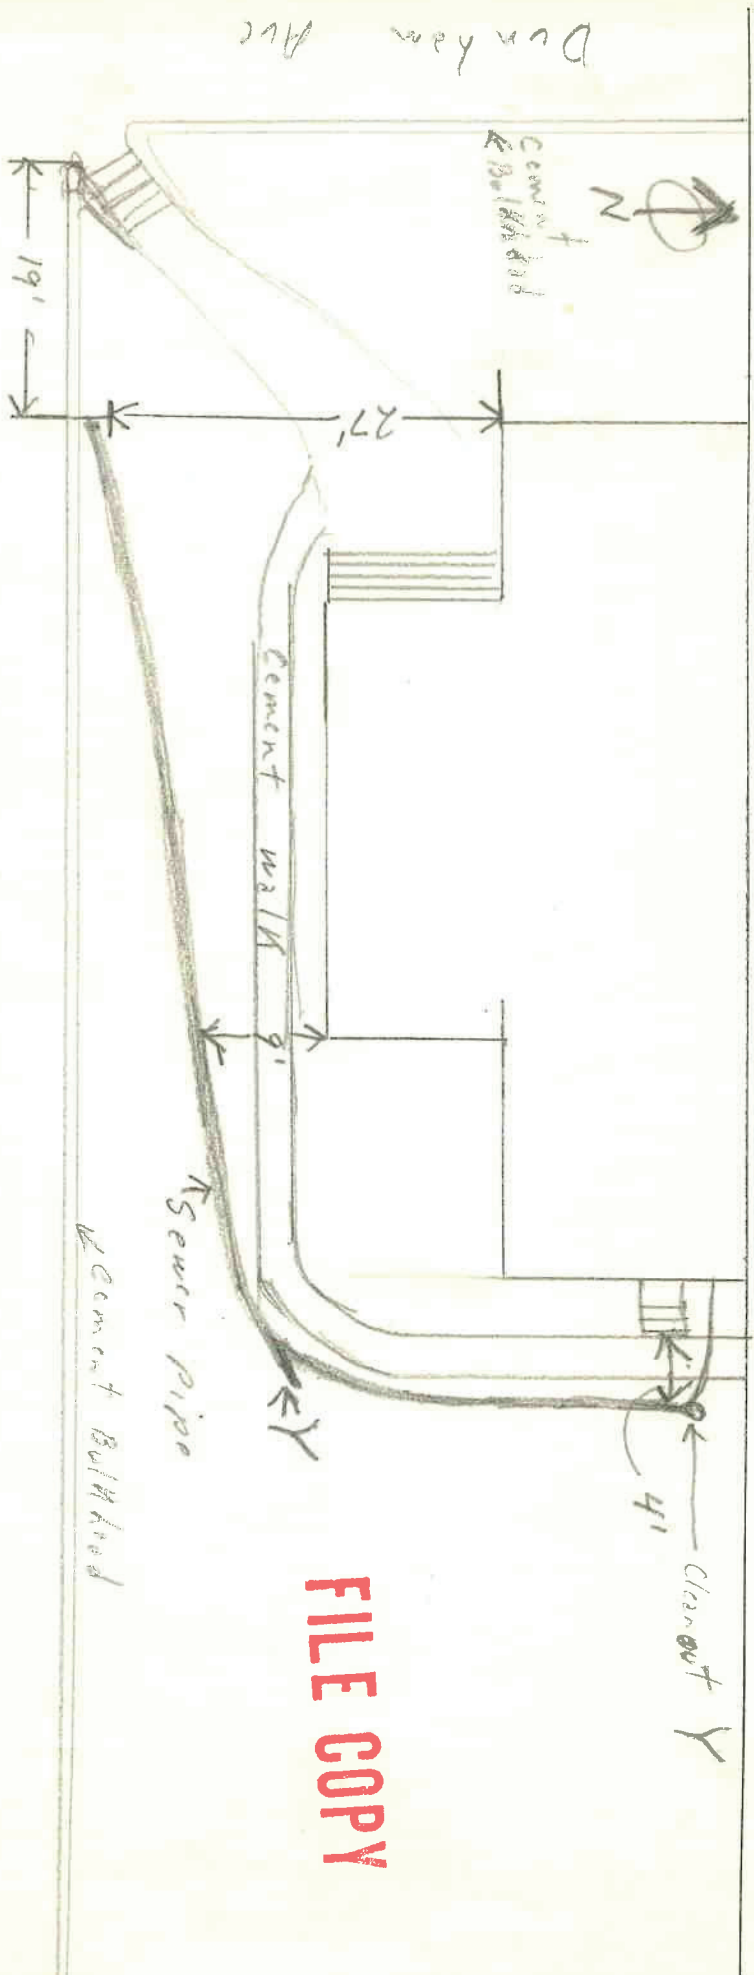

**FILE COPY**

Third ST

04-7100.0

- 1. Commercial..... Single Residence..... Multiple Dwelling..... Joint Use.....
- 2. Distance from property line to sewer line.....
- 3. Distance from house building line to property line..... From property line to bldg. 2 ft
- 4. Min. grade from main to property line.....
- 5. Distance from M. H. No. ....
- 6. Depth: Sewer main.....
- 7. Basement..... Basement connection..... (Reference to first floor)
- 8. Depth of pipe at house connection..... Vitrified Clay..... Asbestos-Cement..... Size 3"
- 9. Type of pipe: Concrete..... Vitrified Clay..... Asbestos-Cement..... Size.....
- 10. Remarks: .....

**COMMERCIAL ONLY**

- 1. Name .....
- 2. Type .....
- 3. Sq. Ft. Floor Space .....
- 4. No. of Floors .....
- 5. Remarks: .....

**SPECIAL AGREEMENTS**

- 1. Grade Release .....
- 2. High Grade Release .....
- 3. Non-Protecting Agmt. ....
- 4. Easement .....
- 5. Permission to Connect .....
- 6. Special .....

I hereby certify that the above connection has been made as shown:

Inspector [Signature] Date 11/1/65  
 Date Permit Issued 1/2/67 Permit No. 557A