


Property Address:	410 West Avenue
Permit Number:	25
Development Name:	NA
Lot Number:	NA
Date Inspected:	01/07/60
Inspected By:	Henry Spencer
AutoCad As-built Drawn By:	Fred Rapelyea
AutoCad Drawing Date:	10/06/05

**FILE COPY**



4" Concrete pipe installed at 2%  
 \* No further information provided by inspector

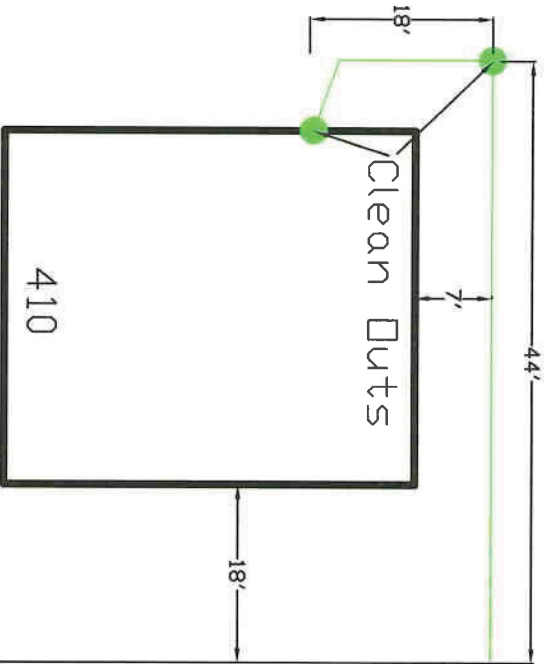

WEST AVENUE