


Owner's Name LESTER HEGUNBLD
 Owner's Mailing Address 412 S Dunham
 Address of Property Same
 Legal Description _____

Side Sewer Contractor Self
 Mailing Address _____

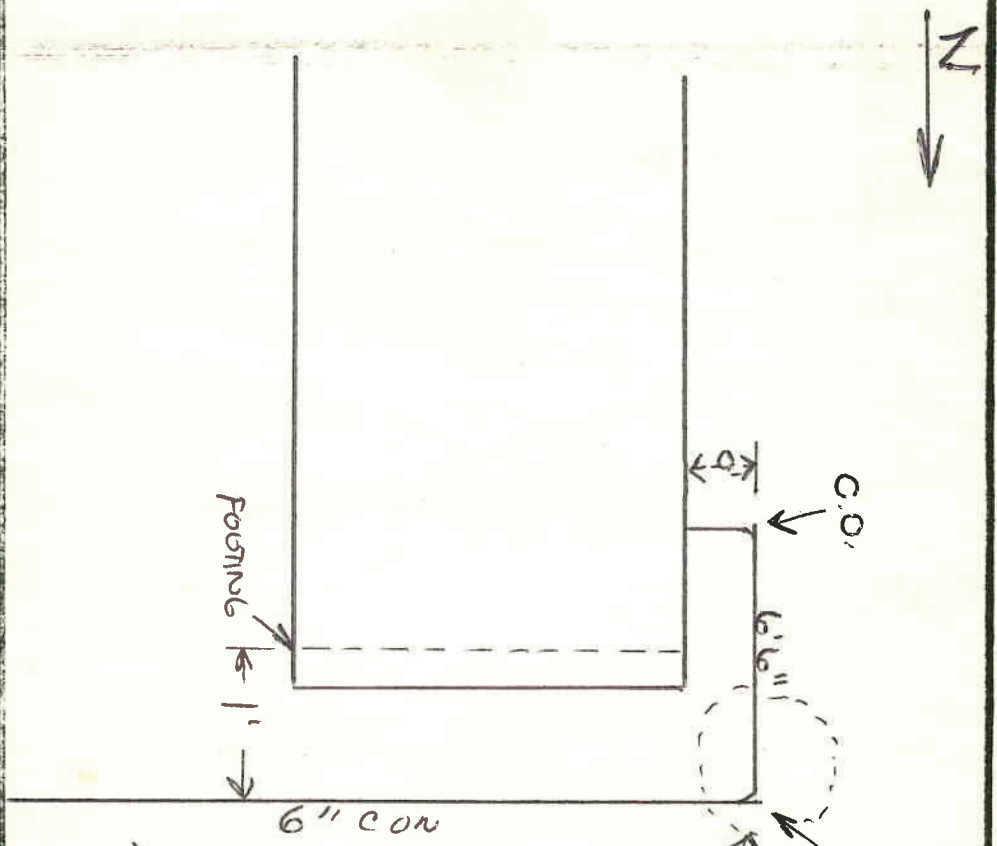

Neighbor to the North
 has S. Dunham pumps
 into this line
 SEPTIC TANK JUST
 UNDER PIPE. BELONGS
 TO HALLING'S FOR
 THEIR BASEMENT ONLY

Backups in this area
 due to large concrete
 pipe. All concrete
 pipe will be replaced
 with 6\"/>

1. Commercial Single Residence Multiple Dwelling Joint Use NORTH HOUSE ALSO
2. Distance from property line to sewer unit _____
3. Distance from house building to property line _____
4. Min. grade from main to property line _____ From property line to building _____
5. Distance from M.H. No. _____
6. Depth: Sewer Main _____ Basement NO _____ Basement Connections _____
7. Depth of pipe at house connection _____ (re: first floor) _____
8. Type of Pipe: concrete Vitrified clay _____ Asbestos cement _____ Size 6"

Robert Schley