

**THE TOWN OF ARLINGTON**  
SEWER DEPARTMENT


Side S & Plat  
(PREPARE IN DUPLICATE)

Permit No. 519

Owner's Name Hildor Ellison  
 Owner's Mailing Address 402 Highland Ave.  
 Legal Description of Premises Arlington Lots 7-8  
 Address of Property 414 S. Olympic  
 Mailing Address Very Code 243-0110 Cobbs ADD To

**FILE COPY**

*Olympic Avenue*

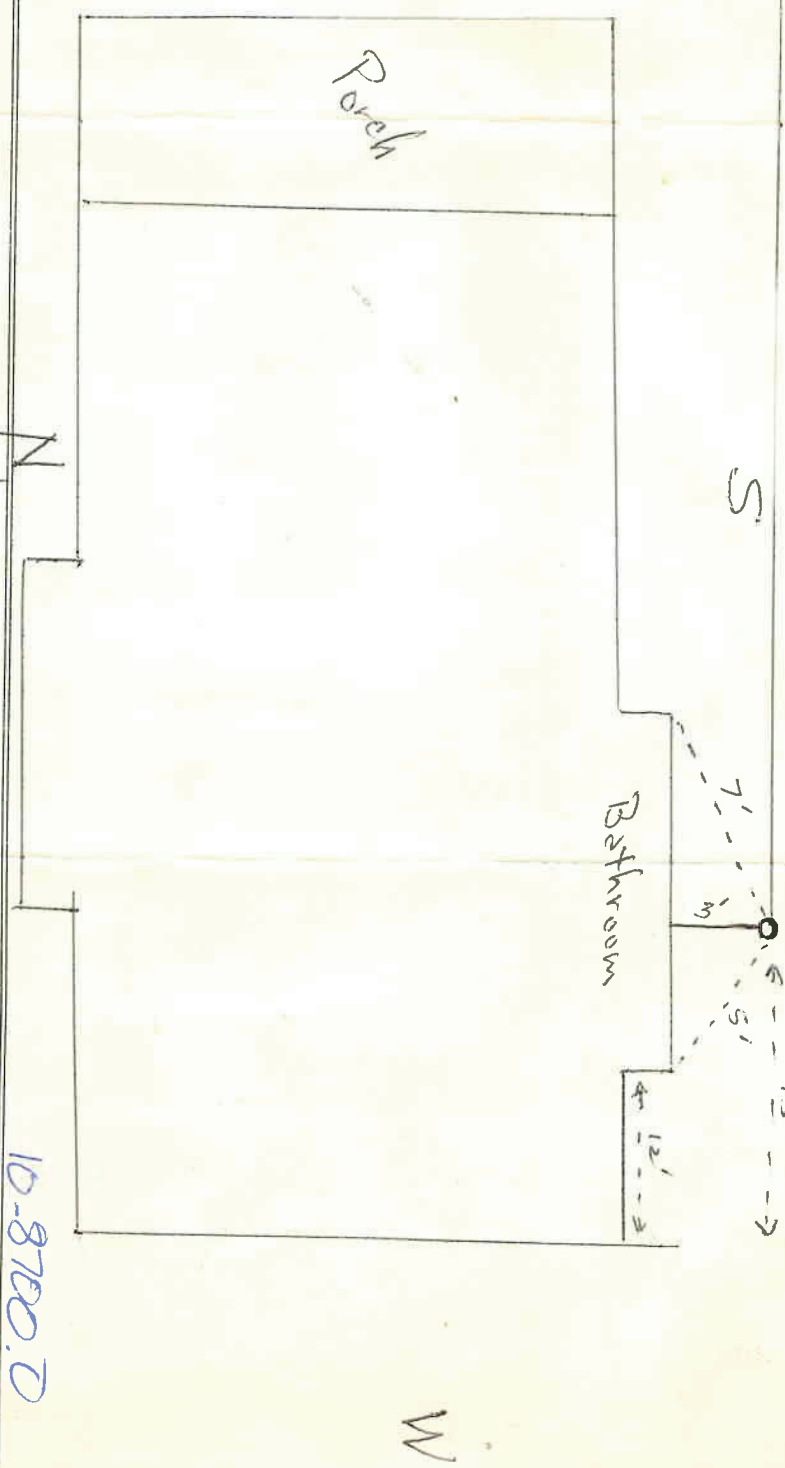

- 1. Commercial..... Single Residence YES Multiple Dwelling..... Joint Use.....
- 2. Distance from property line to sewer line.....
- 3. Distance from house building line to property line..... From property line to bldg. 20'
- 4. Min. Grade from main to property line.....
- 5. Distance from M. H. No. ....
- 6. Depth: Sewer main.....
- 7. Basement..... Basement connection..... (Reference to first floor)
- 8. Depth of pipe at house connection.....
- 9. Type of pipe: Concrete....., Vitrified Clay....., Asbestos-Cement....., Size.....
- 10. Remarks: .....

**COMMERCIAL ONLY**

- 1. Name .....
- 2. Type .....
- 3. Sq. Ft. Floor Space .....
- 4. No. of Floors .....
- 5. Remarks: .....

**SPECIAL AGREEMENTS**

- 1. Grade Release .....
- 2. High Grade Release .....
- 3. Non-Protecting Agmt. ....
- 4. Easement .....
- 5. Permission to Connect .....
- 6. Special .....

I hereby certify that the above connection has been made as shown:  
 Inspector [Signature] Date 7/20/65  
 Date Permit Issued 5/19 Permit No. 519

10-8700.0