


| | |
|----------------------------|----------------|
| Property Address: | 415 Alcazar |
| Permit Number: | 72 |
| Development Name: | NA |
| Lot Number: | NA |
| Date Inspected: | 1/5/60 |
| Inspected By: | Henry Spencer |
| AutoCad As-built Drawn By: | Fred Rappelyea |
| AutoCad Drawing Date: | 2/2/06 |



4" Concrete pipe installed at 2%. Depth of 18" at connection to house.
 Distance from house building line to property line=30 feet.
 * No further information provided by inspector

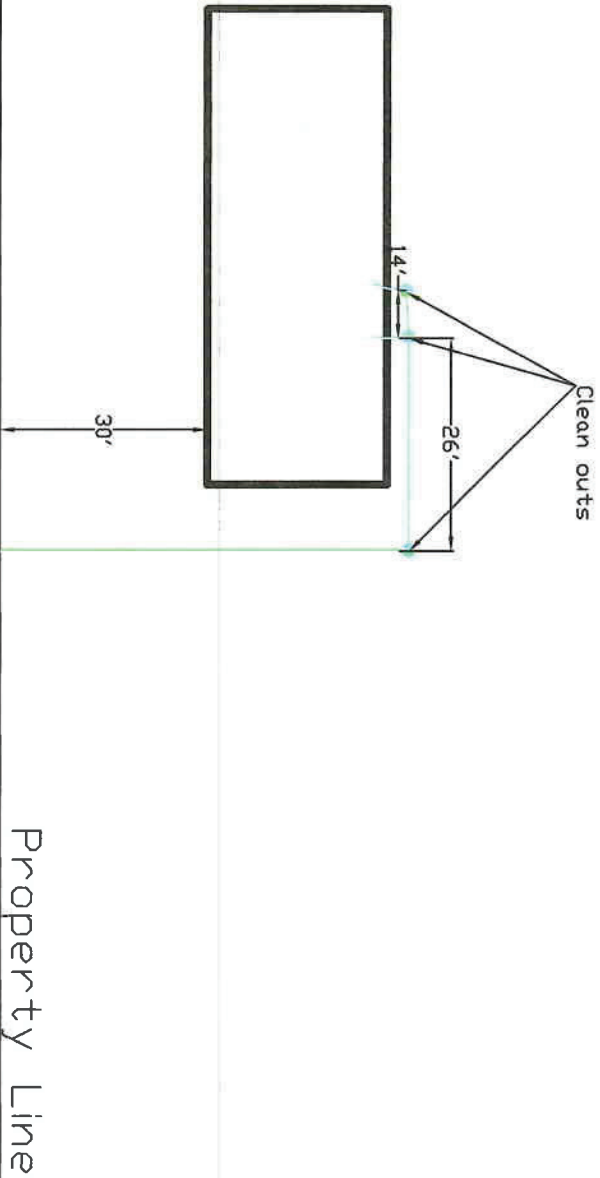

ALCAZAR

Property Line





SIDE SEWER INSPECTION FORM

Department of Public Works • Utilities Division
City of Arlington • 154 W. Cox Street • Arlington, WA 98223 • Phone (360) 403-3526

Site Address: 415 N. Alcazar Ave
Project Name: Josh Roundy
Permit #: _____
Firm/Developer: _____
Contact Person: _____
Contractor: Josh Roundy (360) 631-1044
Initial Inspection Date: 12-22-14

Sewer Permit #: 72
Lot #: _____
Phase: _____
Inspector: Rock Talbot
Phone: _____
Phone: _____
Final Inspection Date: 12-23-14

Staff Comments: see building permit #159

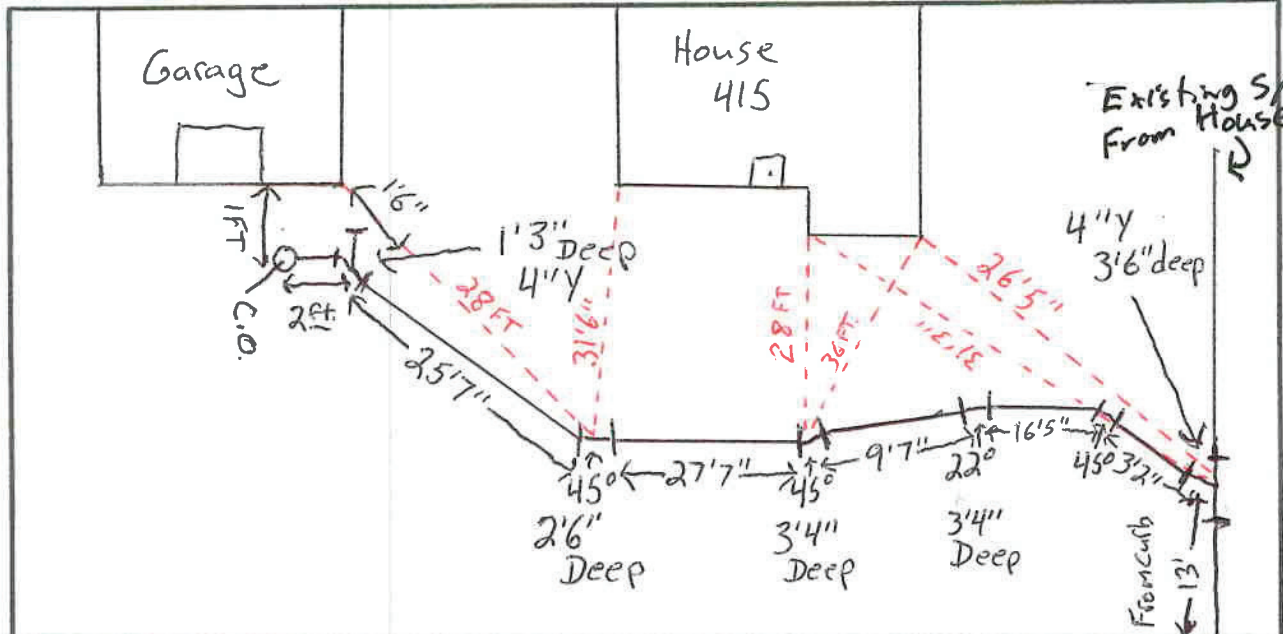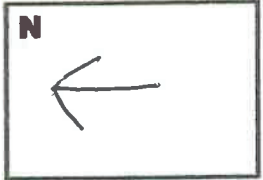

Alcazar