

THE TOWN OF ARLINGTON


SEWER DEPARTMENT

Side S, r Plat
(PREPARE IN DUPLICATE)

Permit No. 277

Owner's Name John Dambis
 Owner's Mailing Address 416 Gilman
 Legal Description of Premises Block 10 - Lots 4-5-6

Address of Property 416 Gilman
 Side Sewer Contractor Self
 Mailing Address Haller City

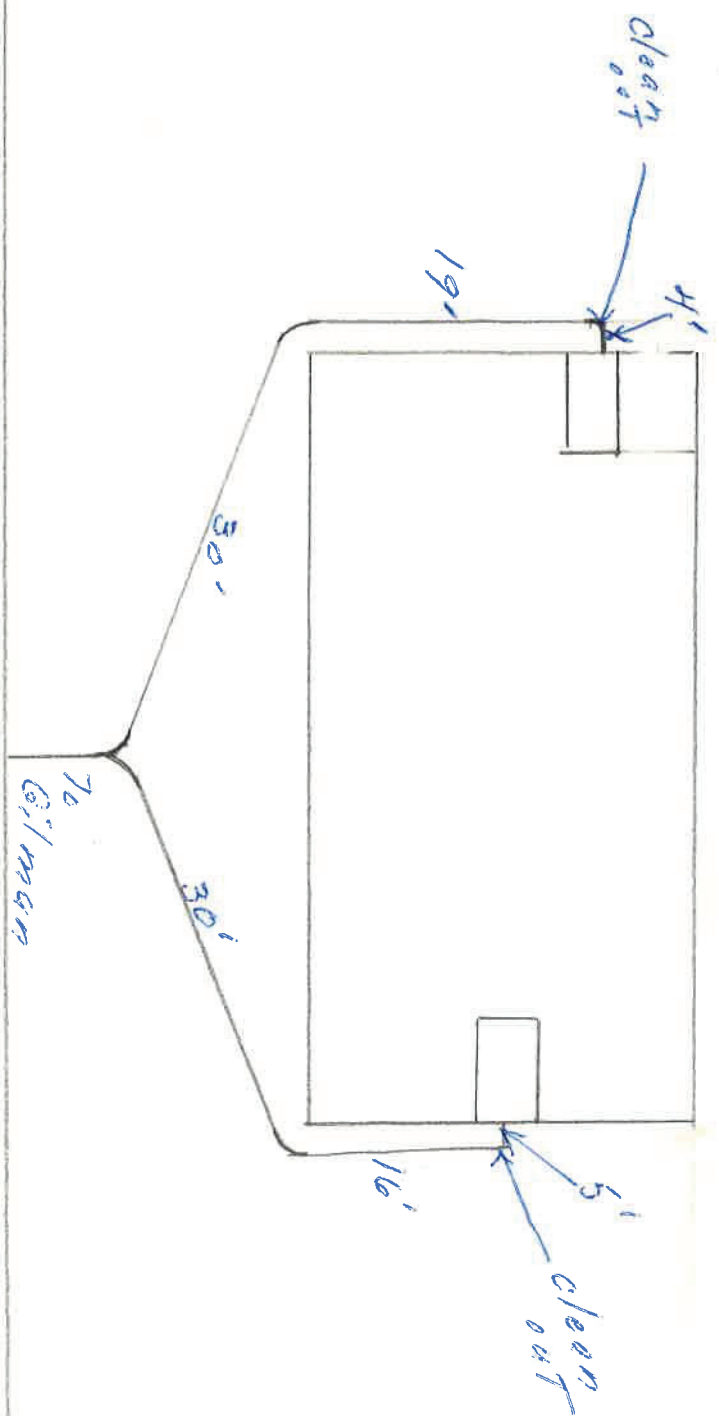

01-78800.0

1. Commercial..... Single Residence..... Multiple Dwelling..... Joint Use.....
2. Distance from property line to sewer line.....
3. Distance from house building line to property line..... From property line to bidg. 280
4. Min. grade from main to property line.....
5. Distance from M. H. No.
6. Depth: Sewer main.....
7. Basement..... Yes Basement connection No (Reference to first floor)
8. Depth of pipe at house connection..... 2 ft Vitrified Clay Asbestos-Cement..... Size 4"
9. Type of pipe: Concrete.....
10. Remarks:

COMMERCIAL ONLY		SPECIAL AGREEMENTS	
1. Name	1. Grade Release	1. High Grade Release	1. Non-Protecting Agmt.
2. Type	2. High Grade Release	2. Non-Protecting Agmt.	2. Easement
3. Sq. Ft. Floor Space	3. Non-Protecting Agmt.	3. Easement	3. Permission to Connect
4. No. of Floors	4. Easement	4. Easement	4. Special
5. Remarks:	5. Permission to Connect	5. Permission to Connect	
	6. Special		

I hereby certify that the above connection has been made as shown:
 Inspector Henry Spencer Date 11/15/60
 Date Permit Issued..... Permit No. 277