


THE TOWN OF ARLINGTON

SEWER DEPARTMENT

Side S Jr Plat
(PREPARE IN DUPLICATE)

Permit No. 393

Owner's Name B. W. Wright
 Owner's Mailing Address 440 W. Dunbar
 Legal Description of Premises Lot 1 & 2 Block 6 District of Columbia
 Address of Property 440 W. Dunbar
 Side Sewer Contractor Ally Self
 Mailing Address 440 W. Dunbar
Washington
Washington

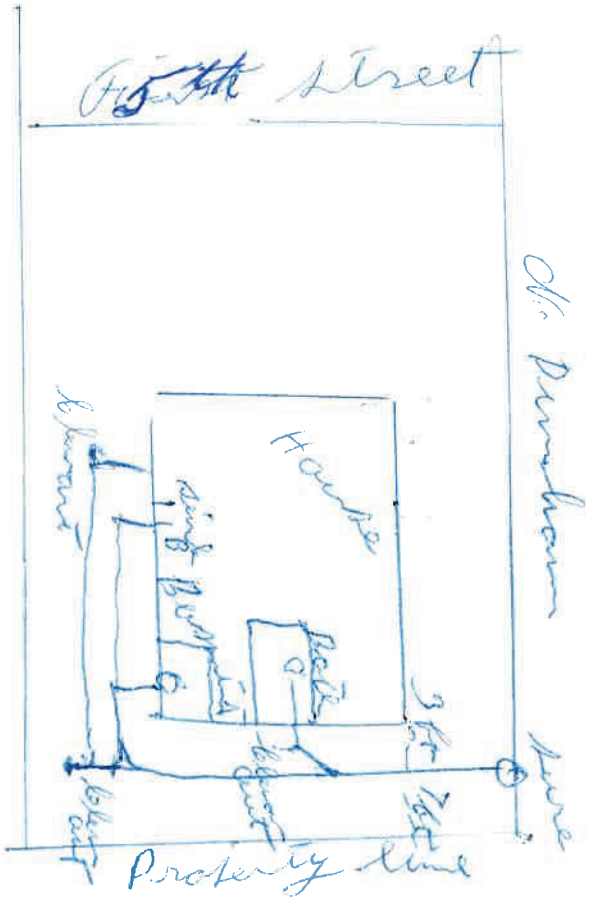

1. Commercial..... Single Residence..... Multiple Dwelling..... Joint Use.....
2. Distance from property line to sewer line.....
3. Distance from house building line to property line.....
4. Min. grade from main to property line..... From property line to bldg. 1/2 in.
5. Distance from M. H. No.
6. Depth: Sewer main..... Basement connection..... (Reference to first floor)
7. Basement..... Vitrified Clay..... Asbestos-Cement..... Size: 4 in.
8. Depth of pipe at house connection.....
9. Type of pipe: Concrete..... Vitrified Clay..... Asbestos-Cement..... Size: 4 in.
10. Remarks:

COMMERCIAL ONLY

SPECIAL AGREEMENTS

1. Name
2. Type
3. Sq. Ft. Floor Space
4. No. of Floors
5. Remarks:
1. Grade Release
2. High Grade Release
3. Non-Protecting Agmt.
4. Easement
5. Permission to Connect
6. Special

04-3500.D

I hereby certify that the above connection has been made as shown:
 Inspector Henry Spencer Date 1/18/60
 Date Permit Issued 1/18/60 Permit No. 393