


Property Address:	500 West Avenue
Permit Number:	21
Development Name:	NA
Lot Number:	NA
Date Inspected:	10/23/86
Inspected By:	R Bruce Schlegel
AutoCad As-built Drawn By:	Fred Rapelyea
AutoCad Drawing Date:	9/16/05

**FILE COPY**



House built after  
side sewer was  
installed due to  
closeness to curb

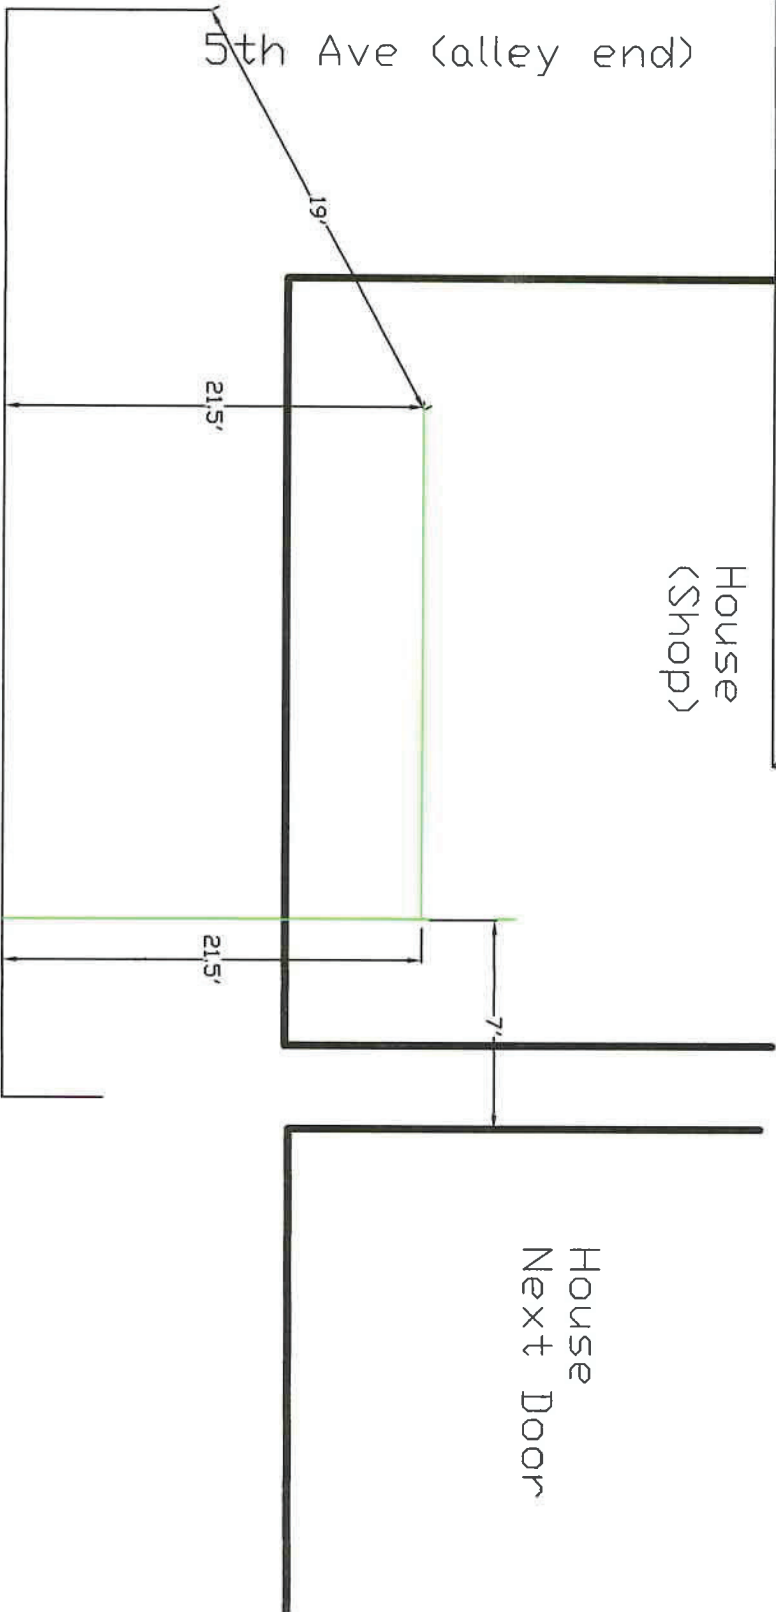

West Avenue