

# THE TOWN OF ARLINGTON

## SEWER DEPARTMENT

Side Street Plat  
(PREPARE IN DUPLICATE)

Permit No. 377 377

6390

Owner's Name Mrs. C. J. Dawson

Owner's Mailing Address 509 Hillcrest, Arlington, Wash.


Mailing Address 509 Hillcrest

Address of Property 509 Hillcrest

Side Sewer Contractor \_\_\_\_\_

Legal Description of Premises

Part of 69.45' Thence E. parallel to E. line of 69.45' Thence N. parallel to S. line of said Tract 69.45' True Tract for 69.45' Thence E. parallel with S. line of said Tract for 104' to the true point of beginning.

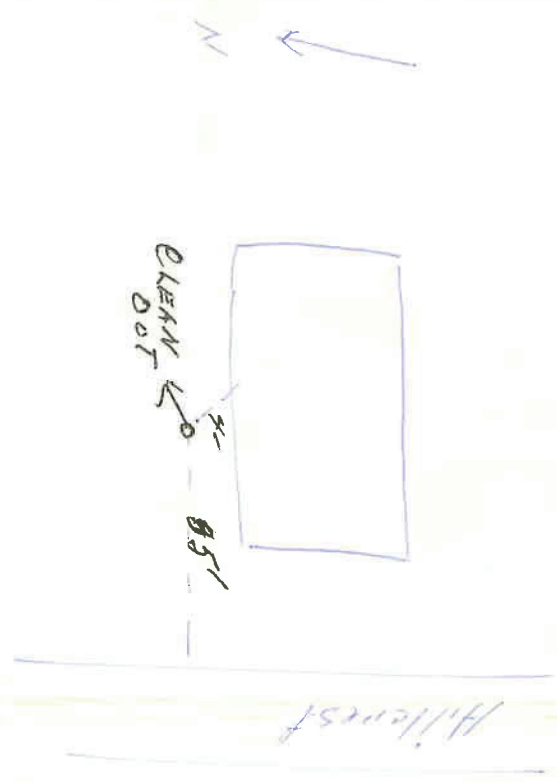

40' from property line to connection  
4' out from center of line to center of line  
35' from property line to clean out.

08-1800.0

1. Commercial..... Single Residence..... Multiple Dwelling..... Joint Use.....

2. Distance from property line to sewer line..... 110'.....

3. Distance from house building line to property line..... 61.5'.....

4. Min. grade from main to property line..... From property line to bldg..... 1.0%.....

5. Distance from M. H. No.....

6. Depth: Sewer main.....

7. Basement..... Basement connection.....

8. Depth of pipe at house connection..... 3'..... (Reference to first floor)

9. Type of pipe: Concrete..... Vitrified Clay..... Asbestos-Cement..... Size..... 4".....

10. Remarks: clean out & down call permit

### COMMERCIAL ONLY

1. Name .....

2. Type .....

3. Sq. Ft. Floor Space .....

4. No. of Floors .....

5. Remarks: .....

### SPECIAL AGREEMENTS

1. Grade Release .....

2. High Grade Release .....

3. Non-Protecting Agmt. ....

4. Easement .....

5. Permission to Connect .....

6. Special .....

I hereby certify that the above connection has been made as shown:

Inspector George Spencer Date 11/2/69

Date Permit Issued..... Permit No. 377