

THE TOWN OF ARLINGTON


SEWER DEPARTMENT

Side S, r Plat
(PREPARE IN DUPLICATE)

Permit No. 78
5190

Owner's Name CORP OF CATHOLIC ARCHBISHOP OF SEATTLE Address of Property 512 3rd ST. ARLINGTON WASH.
 Owner's Mailing Address 512 3rd ST. ARLINGTON WASH. Side Sewer Contractor THORNTON & LOGAN
 Legal Description of Premises LOTS 1-2-3 & 4 BLOCK 1 GREENBARD'S 1st ADDITION Mailing Address 4608 36th AVE SW SEATTLE 6

3rd ST.

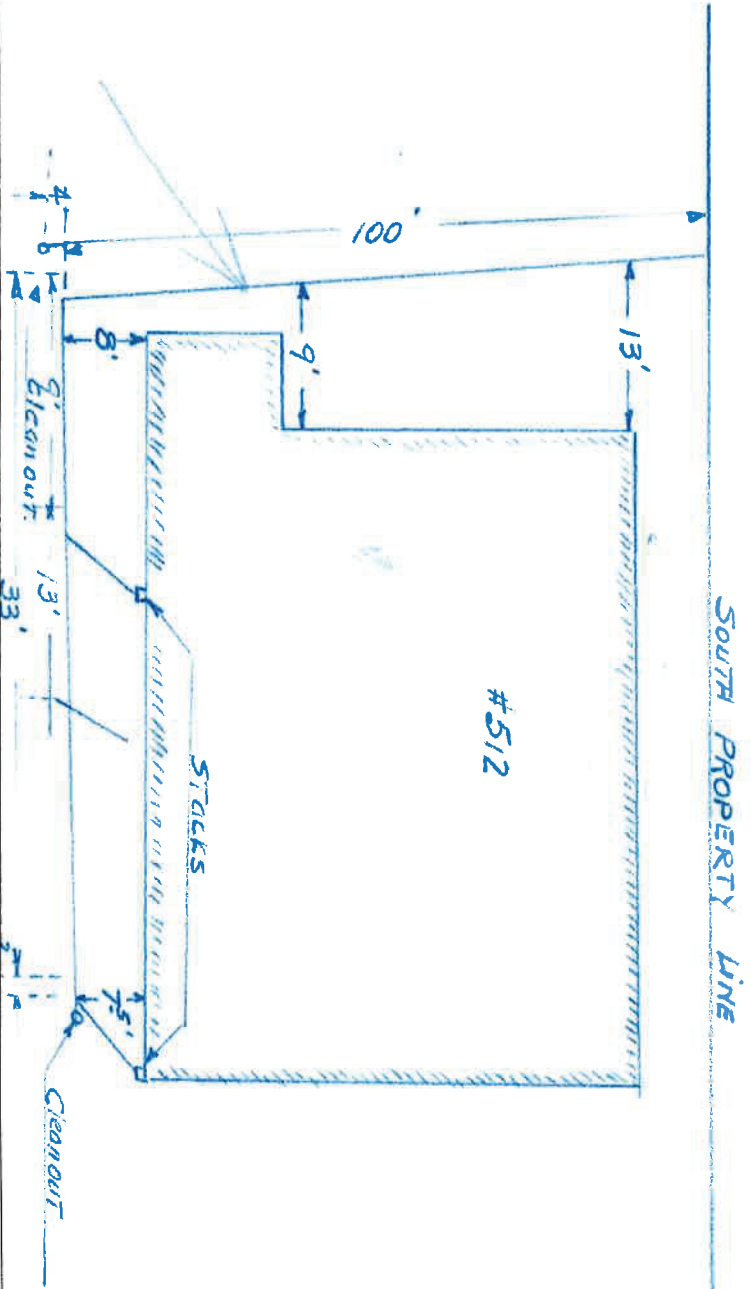

COMMERCIAL ONLY

SPECIAL AGREEMENTS

- Commercial..... Single Residence..... Multiple Dwelling..... Joint Use.....
- Distance from property line to sewer line.....
- Distance from house building line to property line..... From property line to bldg.....
- Min. grade from main to property line.....
- Distance from M. H. No.....
- Depth: Sewer main.....
- Basement..... Basement connection..... (Reference to first floor)
- Depth of pipe at house connection.....
- Type of pipe: Concrete..... Vitrified Clay..... Asbestos-Cement.....
- Remarks:.....

- Name.....
 - Type.....
 - Sq. Ft. Floor Space.....
 - No. of Floors.....
 - Remarks:.....
- I hereby certify that the above connection has been made as shown:
- Inspector [Signature] Date 11-11-78 Permit No. 78

06-3800.D