

# THE TOWN OF ARLINGTON

## SEWER DEPARTMENT


Side Street Plat  
(PREPARE IN DUPLICATE)

Permit No. 05-9

Owner's Name Richard E. Gandy  
 Owner's Mailing Address 5114 Woodland Dr. Ard  
 Legal Description of Premises 11-88-5-02-16  
8 Seely TRF 249 to P&B TH 930 TH 180 TH 1081 to P&B  
403 RDS.

Address of Property 5114 Woodland Dr  
 Side Sewer Contractor Richard E. Gandy  
 Mailing Address Box 114 for Condo 91411  
RD 1081 to P&B

Section cut from Mark's most corner of  
 House down cut out two feet deep to  
 clean out by.

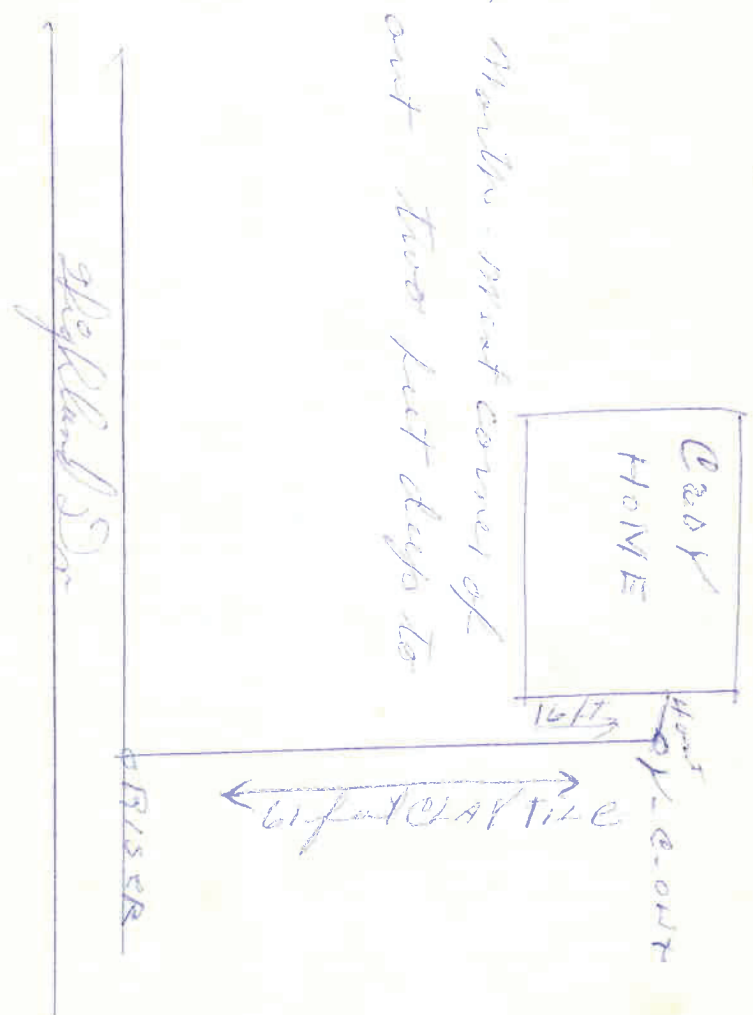

08-3500.0

- 1. Commercial..... Single Residence  Multiple Dwelling..... Joint Use.....
- 2. Distance from property line to sewer line.....
- 3. Distance from house building line to property line..... From property line to bldg. 20 ft
- 4. Min. grade from main to property line.....
- 5. Distance from M. H. No.....
- 6. Depth: Sewer main.....
- 7. Basement..... Basement connection..... (Reference to first floor)
- 8. Depth of pipe at house connection.....
- 9. Type of pipe: Concrete..... Vitrified Clay..... Asbestos-Cement....., Size.....
- 10. Remarks:.....

- COMMERCIAL ONLY**
- 1. Name.....
  - 2. Type.....
  - 3. Sq. Ft. Floor Space.....
  - 4. No. of Floors.....
  - 5. Remarks:.....
- SPECIAL AGREEMENTS**
- 1. Grade Release.....
  - 2. High Grade Release.....
  - 3. Non-Professing Agmt.....
  - 4. Easement.....
  - 5. Permission to Connect.....
  - 6. Special.....
- I hereby certify that the above connection has been made as shown:  
 Inspector Richard E. Gandy Date 11/16/05  
 Date Permit Issued..... Permit No. 05-9