

THE TOWN OF ARLINGTON


SEWER DEPARTMENT

Side Street Plat
(PREPARE IN DUPLICATE)

Permit No. 219 / 6220

Owner's Name Raymond Harnell
 Owner's Mailing Address 517 - S - Olympic
 Legal Description of Premises 5' Th. E. 144' Th. N. 508.5' Th. W. 144' Th. S. 40' Th. E. 469' Th. S.P.R. Th. S. 222.5' Th. E. 144' Th. N. 508.5' Th. W. 144' Th. S. 235.5' Th. W. of

Address of Property 517 - S - Olympic
 Side Sewer Contractor Arthur Hume and Sons
 Mailing Address 1605 - 26th S.W. Seattle

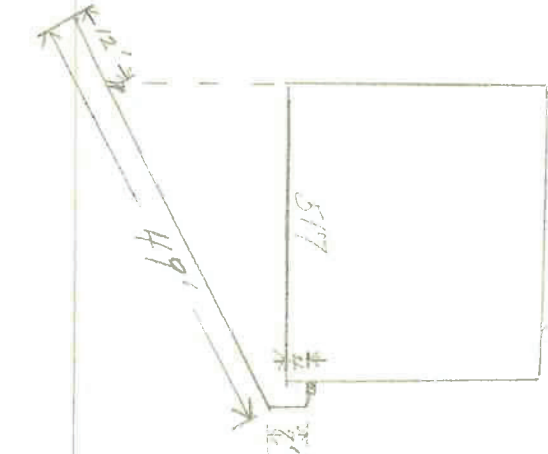

5 - Olympic

Main 8.9' deep

08-6500-0

1. Commercial Single Residence Multiple Dwelling Joint Use
 2. Distance from property line to sewer line
 3. Distance from house building line to property line
 4. Min. grade from main to property line From property line to bldg. 1/2"
 5. Distance from M. H. No.
 6. Depth: Sewer main
 7. Basement Basement connection (Reference to first floor)
 8. Depth of pipe at house connection
 9. Type of pipe: Concrete Vitrified Clay Asbestos-Cement Size 4"
 10. Remarks:

COMMERCIAL ONLY		SPECIAL AGREEMENTS	
1. Name	1. Grade Release		
2. Type	2. High Grade Release		
3. Sq. Ft. Floor Space	3. Non-Protecting Agmt.		
4. No. of Floors	4. Easement		
5. Remarks:	5. Permission to Connect		
	6. Special		

I hereby certify that the above connection has been made as shown:
 Inspector George Spence Date 11/7/58
 Date Permit Issued Permit No. 219