

THE TOWN OF ARLINGTON


SEWER DEPARTMENT

Side Sewer Plat
(PREPARE IN DUPLICATE)

Permit No. 357

Owner's Name Chara Bird
 Owner's Mailing Address 518-East 3rd Street
 Legal Description of Premises W-65' OF LOTS 19 & 20

Address of Property 518-East 3rd Street
 Side Sewer Contractor None
 Mailing Address 518-East 3rd Street
GIFFORD FIRST ADDITION

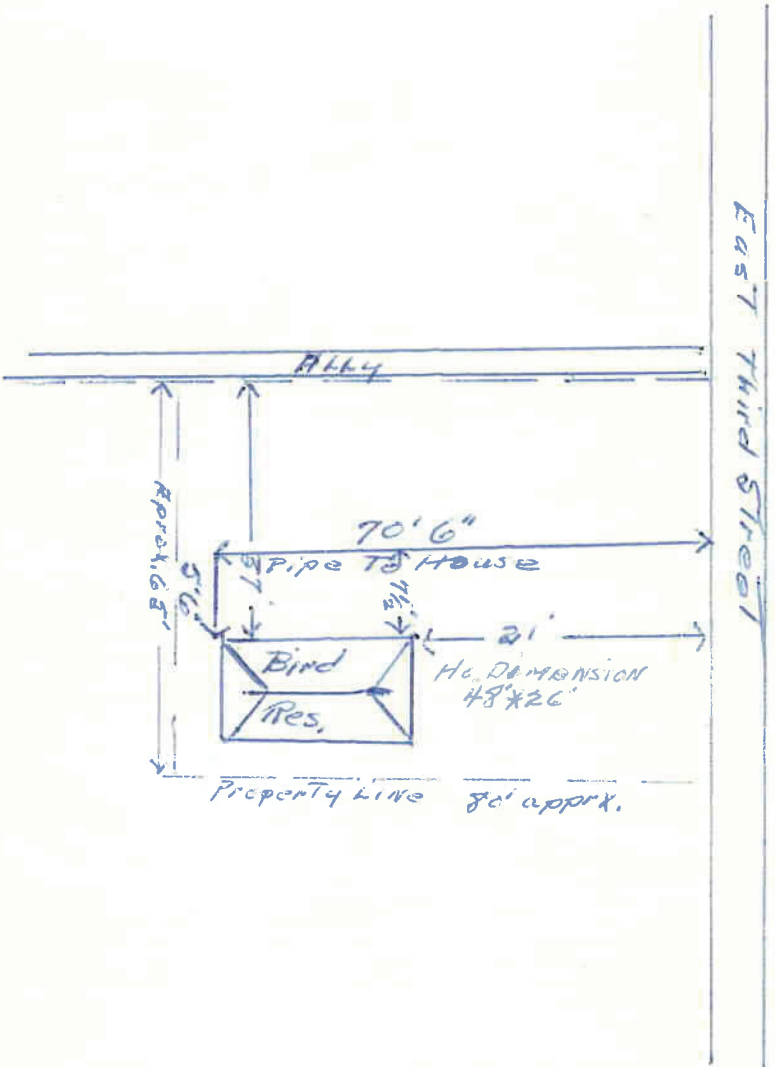

06-8300.0

- 1. Commercial..... Single Residence Multiple Dwelling..... Joint Use.....
- 2. Distance from property line to sewer line.....
- 3. Distance from house building line to property line..... From property line to bldg. 2 feet
- 4. Min. grade from main to property line.....
- 5. Distance from M. H. No.
- 6. Depth: Sewer main..... Basement connection.....
- 7. Basement.....
- 8. Depth of pipe at house connection 30", Vitrified Clay , Asbestos-Cement (Reference to first floor)
- 9. Type of pipe: Concrete....., Size 4"
- 10. Remarks:

- COMMERCIAL ONLY**
- 1. Name
 - 2. Type
 - 3. Sq. Ft. Floor Space
 - 4. No. of Floors
 - 5. Remarks:

- SPECIAL AGREEMENTS**
- 1. Grade Release
 - 2. High Grade Release
 - 3. Non-Protecting Agmt.
 - 4. Easement
 - 5. Permission to Connect
 - 6. Special

I hereby certify that the above connection has been made as shown:
 Inspector Wm. J. G. ... Date 11/6/69
 Date Permit Issued..... Permit No. 357