

THE TOWN OF ARLINGTON

SEWER DEPARTMENT


Side Street Plat
(PREPARE IN DUPLICATE)

Permit No. 411

Owner's Name A.D. Bennett
 Owner's Mailing Address P.O. Box 42
 Legal Description of Premises 5.00 Corner Lot 2, Ross Armstrong's Suburban Farm Tracts.

Address of Property 518 Hill Crest Dr.
 Side Sewer Contractor Charles Smyth

Mailing Address

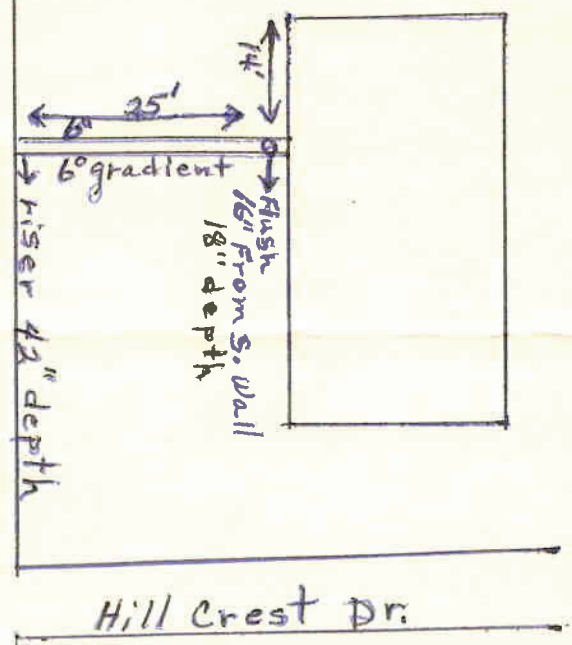

08-8300.0

1. Commercial..... Single Residence 1 Multiple Dwelling..... Joint Use.....
2. Distance from property line to sewer line..... 25'
3. Distance from house building line to property line..... From property line to bldg.....
4. Min. grade from main to property line.....
5. Distance from M. H. No.....
6. Depth: Sewer main.....
7. Basement..... Yes Basement connection..... 7.0 (Reference to first floor)
8. Depth of pipe at house connection.....
9. Type of pipe: Concrete..... Vitrified Clay..... Asbestos-Cement..... Size 4"
10. Remarks: check pipe to change pump

COMMERCIAL ONLY

1. Name
2. Type
3. Sq. Ft. Floor Space
4. No. of Floors
5. Remarks:

SPECIAL AGREEMENTS

1. Grade Release
2. High Grade Release
3. Non-Protecting Agmt.
4. Easement
5. Permission to Connect
6. Special

I hereby certify that the above connection has been made as shown:
 Inspector [Signature] Date 1/30/63
 Date Permit Issued [Signature] Permit No. 411

6352