



CONCRETE PRODUCTS

19604 - 67th Ave NE Arlington, WA 98223
Tele. (360) 435-5531 Fax (360) 435-8575

Customer _____

Job _____

Date _____ Date Req. _____

Approved By _____

PRODUCTS:

- Manholes 48" thru 96"
- Catch Basins Type 30 thru 96"
- Electrical Vaults
- Oil / Water Separators
- Grease Interceptors
- Coalescing Vaults
- Detector Vaults
- Trench Boxes
- Septic Tanks
- Drainage Weirs
- Box Culvert
- All Types of Pipe & Culvert
- Alum. & Galv. Hatches
- Custom Concrete Products


SERVICES:

- Complete Vactor Service
- Video Inspection
- Core Drilling
- High Pressure Jetting
- Septic Tank Pumping
- Sewer Line Taps & Boots
- Pump Replacement

MH# _____ Top _____


Size _____ Inv. _____

~~522~~ 522 E Hilman
Permit # 370

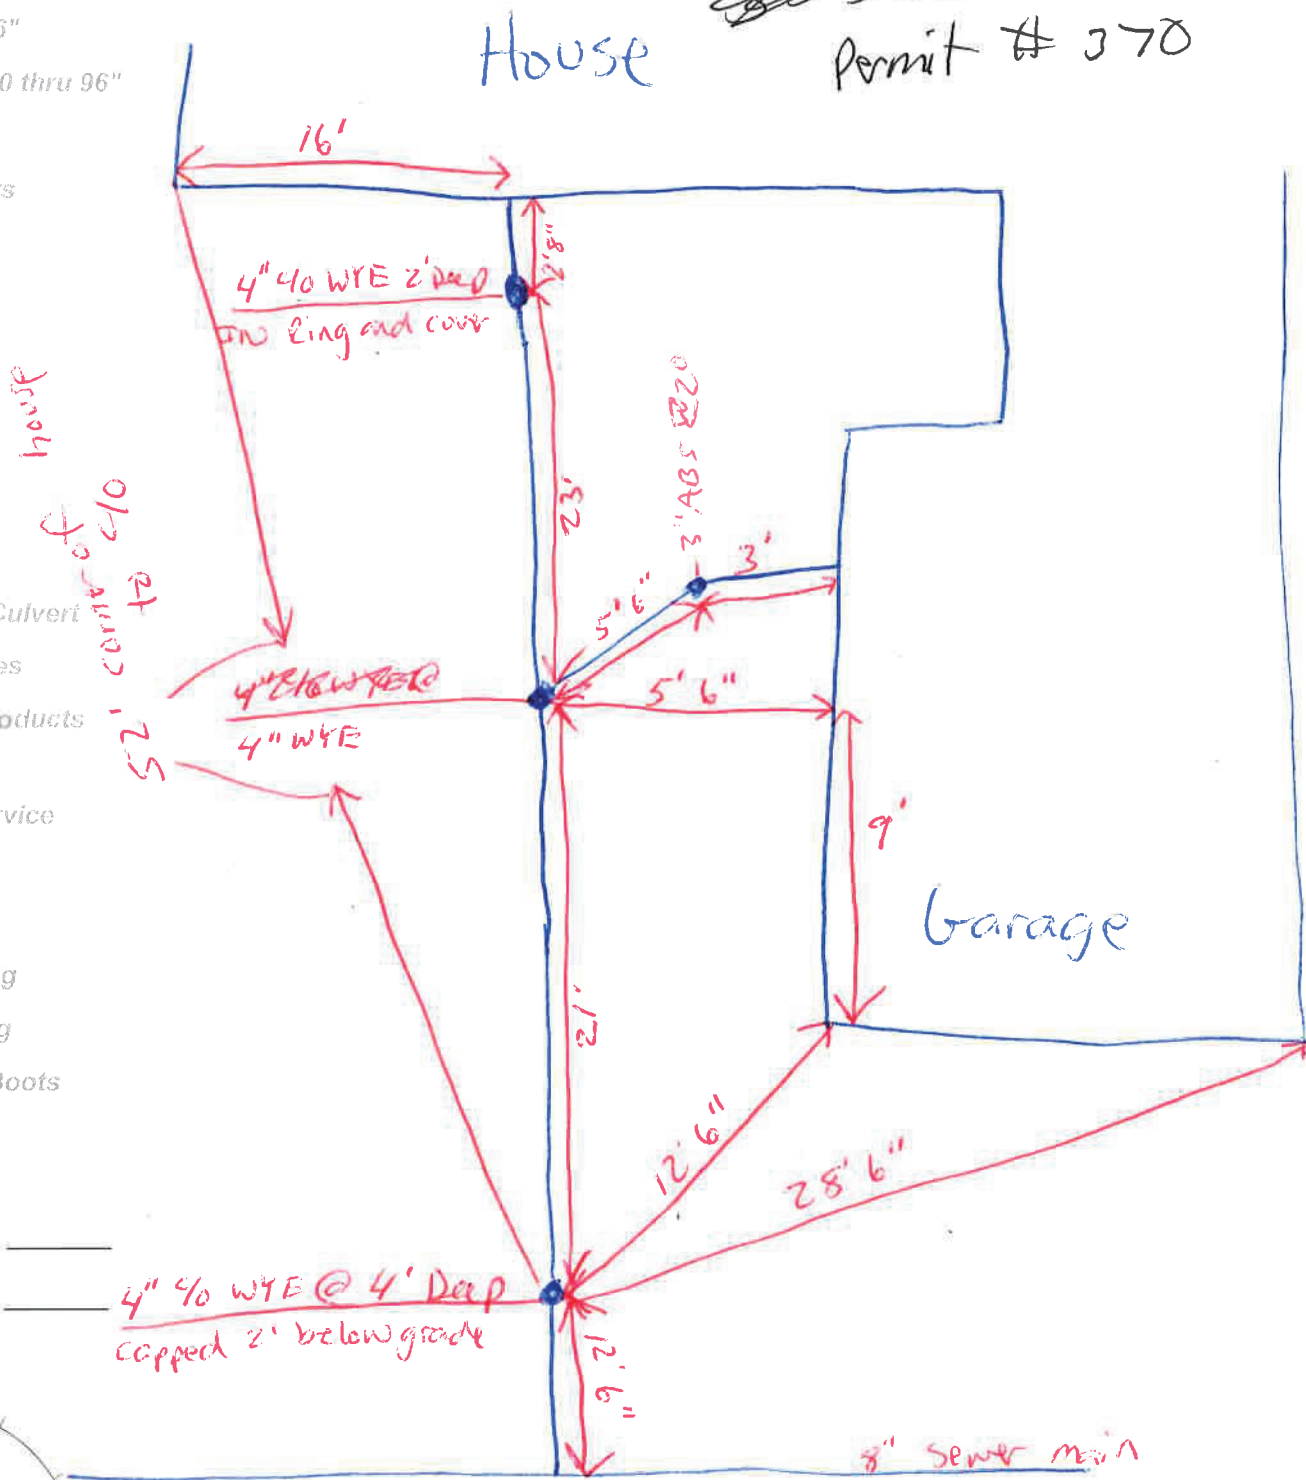

House

Garage

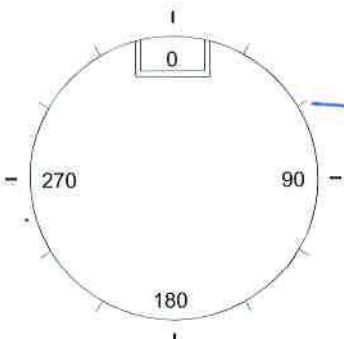

8" sewer main