


Property Address:	523 High St.
Permit Number:	06
Development Name:	NA
Lot Number:	NA
Date Inspected:	01/05/60
Inspected By:	Henry Spencer
AutoCad As-built Drawn By:	Fred Rapelyea
AutoCad Drawing Date:	5/03/05

FILE COPY



4" Concrete pipe installed at 2%, C/D 18" deep at house
 * No further information provided by inspector

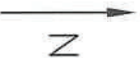