

THE TOWN OF ARLINGTON


SEWER DEPARTMENT

Side Sheet Plat
(PREPARE IN DUPLICATE)

Permit No. 545

Owner's Name John A. Pickett
 Owner's Mailing Address 902 E. Maple
 Legal Description of Premises 5th St 26x14, 18

Address of Property COH 5th St
 Side Sewer Contractor Lane
 Mailing Address _____

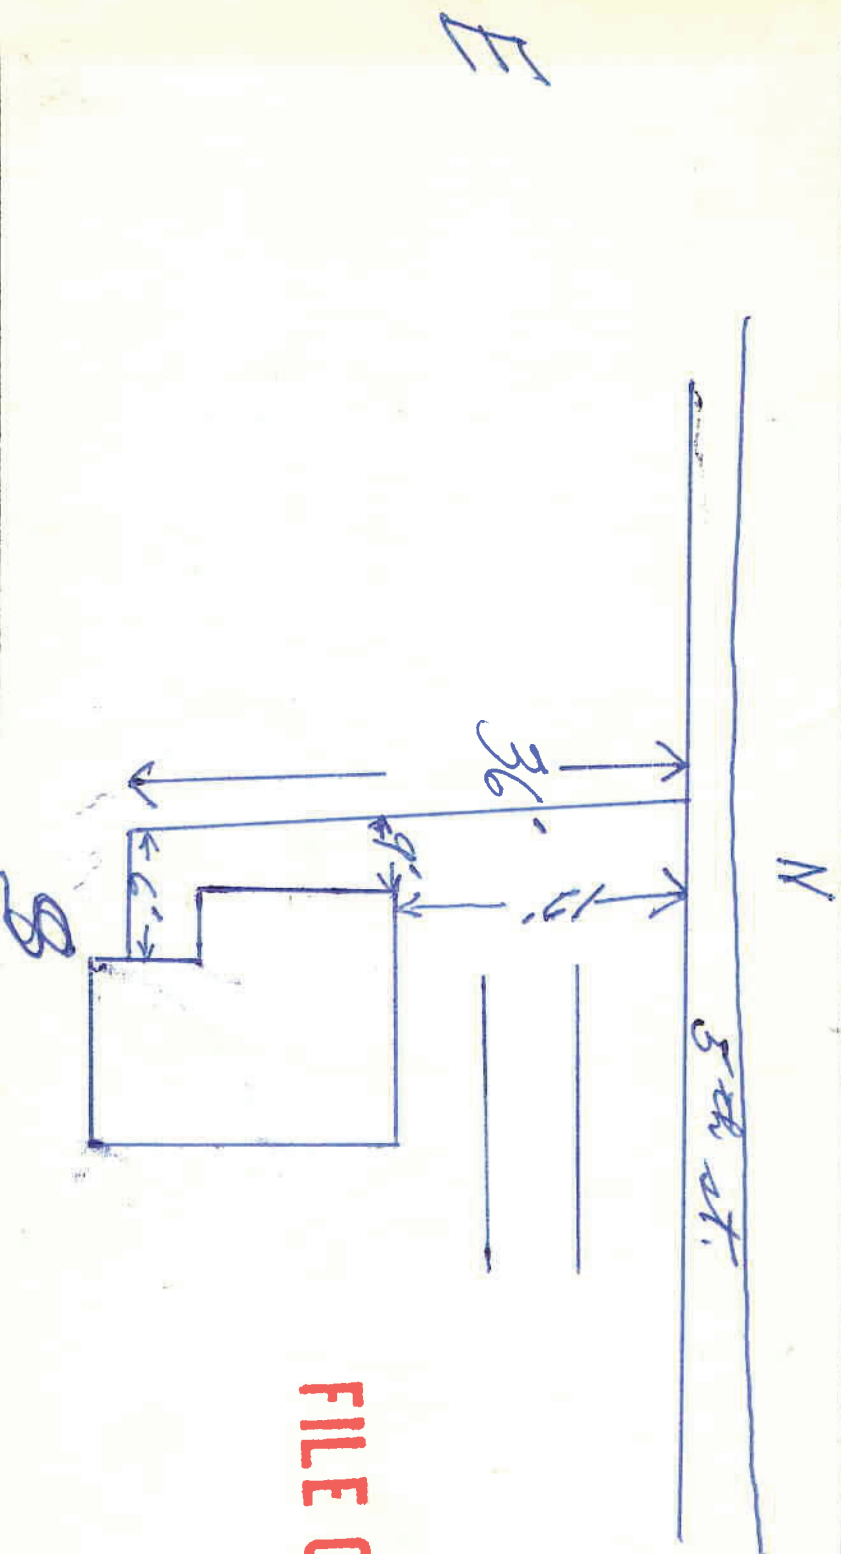

FILE COPY

04-87000

1. Commercial..... Single Residence..... Multiple Dwelling..... Joint Use.....
2. Distance from property line to sewer line.....
3. Distance from house building line to property line..... From property line to bldg. 2 1/2
4. Min. grade from main to property line.....
5. Distance from M. H. No. 16"
6. Depth: Sewer main..... Basement connection..... (Reference to first floor)
7. Basement.....
8. Depth of pipe at house connection..... Vitrified Clay..... Asbestos-Cement..... Size 4"
9. Type of pipe: Concrete.....
10. Remarks:.....

COMMERCIAL ONLY

1. Name
2. Type
3. Sq. Ft. Floor Space
4. No. of Floors
5. Remarks:

SPECIAL AGREEMENTS

1. Grade Release
2. High Grade Release
3. Non-Protecting Agmt.
4. Easement
5. Permission to Connect
6. Special

I hereby certify that the above connection has been made as shown:
 Inspector [Signature] Date 3/20/65
 Date Permit Issued _____ Permit No. 345