


FILE COPY

Property Address: 606 Highland Drive
Permit Number: 32
Development Name: NA
Lot Number: NA
Date Inspected: 01/07/60
Inspected By: Henry Spencer
AutoCAD As-built Drawn By: Fred Rapelyea
AutoCAD Drawing Date: 10/07/05



4" Concrete pipe installed at 2%
* No further information provided by inspector

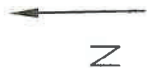