

THE TOWN OF ARLINGTON

SEWER DEPARTMENT

Side Street Plat
(PREPARE IN DUPLICATE)

Permit No. 59

5910

Owner's Name RALPH J. BOURGETTE

Owner's Mailing Address 624 HIGHLAND DRIVE


Legal Description of Premises PT. 42 - E. 100 FT. OF BEG. 20 FT. S. AND 593 FT. W. OF NE. COR. SE. 1/4 THENCE S. 43.56 FT. THENCE W. 300 FT. THENCE N. 43.56 FT. THENCE E. 300 FT. TO POINT OF BEGINNING.

Address of Property 624 HIGHLAND DRIVE

Side Sewer Contractor THORBURN & LOGOZO

Mailing Address 4608 36th AVE SW - SEATTLE 6

4 HIGHLAND DRIVE

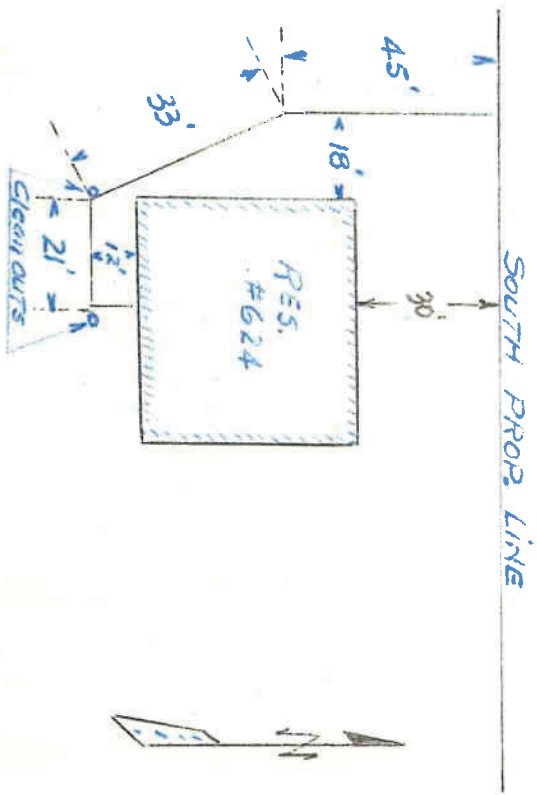

08-2800.0

- Commercial..... Single Residence..... Multiple Dwelling..... Joint Use.....
- Distance from property line to sewer line.....
- Distance from house building line to property line..... From property line to bldg. 11'
- Min. grade from main to property line.....
- Distance from M. H. No.
- Depth: Sewer main.....
- Basement..... Basement connection..... (Reference to first floor)
- Depth of pipe at house connection.....
- Type of pipe: Concrete....., Vitrified Clay....., Asbestos-Cement....., Size.....
- Remarks:

COMMERCIAL ONLY

- Name
- Type
- Sq. Ft. Floor Space
- No. of Floors
- Remarks:

SPECIAL AGREEMENTS

- Grade Release
- High Grade Release
- Non-Protecting Agmt.
- Easement
- Permission to Connect
- Special

I hereby certify that the above connection has been made as shown:

Inspector [Signature] Date 1/16/60
 Date Permit Issued..... Permit No. 59