

THE TOWN OF ARLINGTON

SEWER DEPARTMENT


Side Sewer Plat
(PREPARE IN DUPLICATE)

Permit No. 360

6980

Owner's Name Mr. J. Murphy
 Owner's Mailing Address 625 Highland Drive
 Legal Description of Premises _____

Address of Property 625 Highland Drive
 Side Sewer Contractor Chas. Stewart
 Mailing Address 414 So. Corners St. Wash

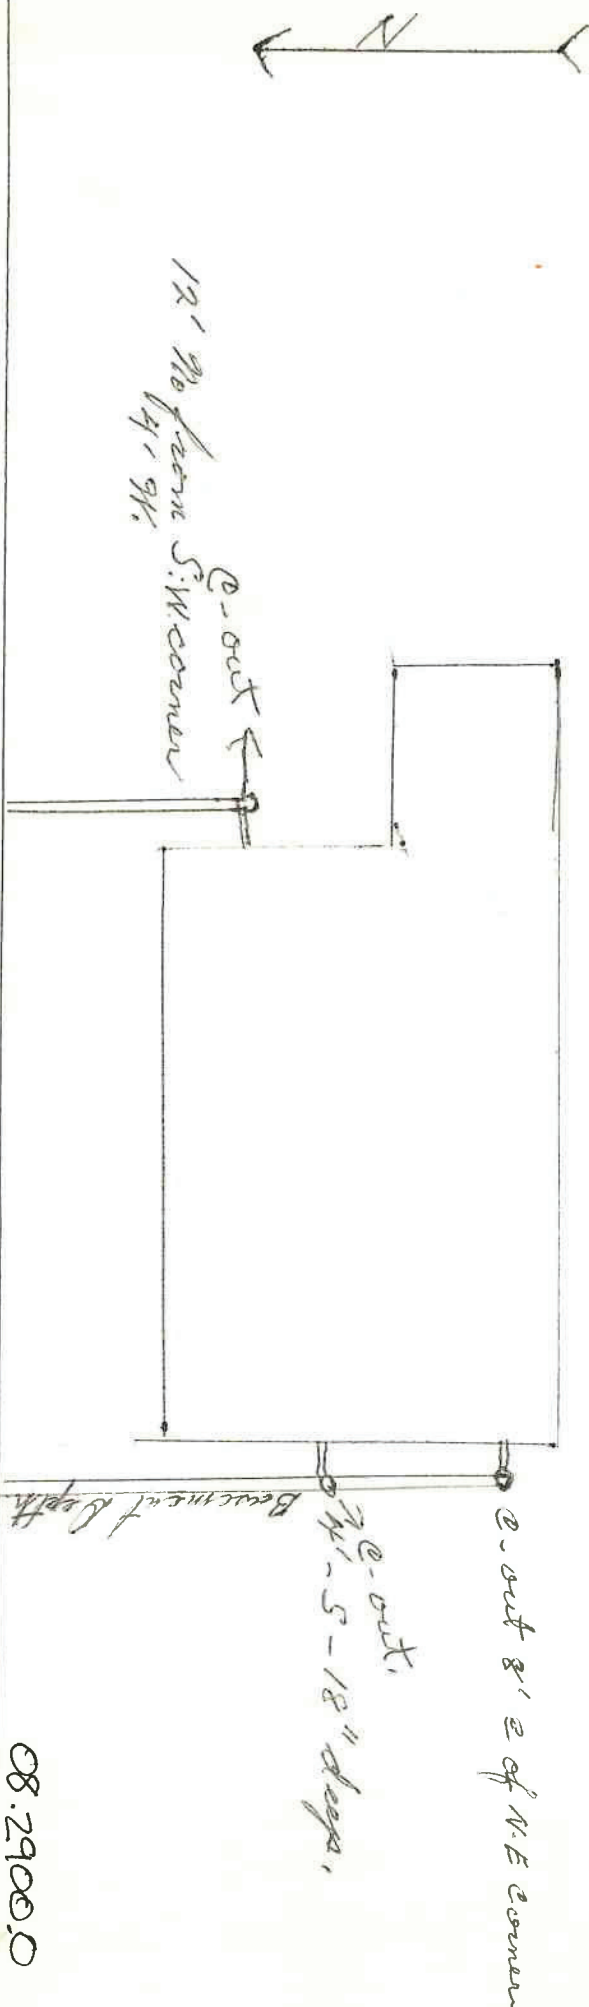

08.290000

- 1. Commercial..... Single Residence..... Multiple Dwelling..... Joint Use.....
- 2. Distance from property line to sewer line.....
- 3. Distance from house building line to property line..... From property line to bldg. 20' 1/2
- 4. Min. grade from main to property line.....
- 5. Distance from M. H. No.
- 6. Depth: Sewer main..... Basement connection..... (Reference to first floor)
- 7. Basement.....
- 8. Depth of pipe at house connection..... Vitrified Clay..... Asbestos-Cement..... Size 4"
- 9. Type of pipe: Concrete.....
- 10. Remarks: Lines traced

- COMMERCIAL ONLY
- 1. Name.....
 - 2. Type.....
 - 3. Sq. Ft. Floor Space.....
 - 4. No. of Floors.....
 - 5. Remarks:.....

- SPECIAL AGREEMENTS
- 1. Grade Release.....
 - 2. High Grade Release.....
 - 3. Non-Protecting Agmt.
 - 4. Easement.....
 - 5. Permission to Connect.....
 - 6. Special.....

I hereby certify that the above connection has been made as shown:
 Inspector Henry Spurr Date 11/16/60
 Date Permit Issued _____ Permit No. 360