

THE TOWN OF ARLINGTON

SEWER DEPARTMENT

Side Sewer Plat
(PREPARE IN DUPLICATE)

Permit No. 263

0930


Owner's Name P.H. Stride
 Owner's Mailing Address Box 49 Arlington Va 22207

Address of Property 717 Highland Drive
 Mailing Address Box 419 A Corner Wash

Legal Description of Premises See 11 Sub 31 R5 Pt 36 A Bay S8 Cor SE 1/4 NE 1/4 The W 1/2 S 1/2 Sec 20 T. P. B.

The N 200' of the W 1/2' with the S 200'
To 1/4 Sec the N 1/2' with 1/2 Sec
T. P. B. Sec 20 Cor. R. 2.

2nd CLEAN OUT IS FROM N.E.
CORNER OF BACK DOOR. N.E.

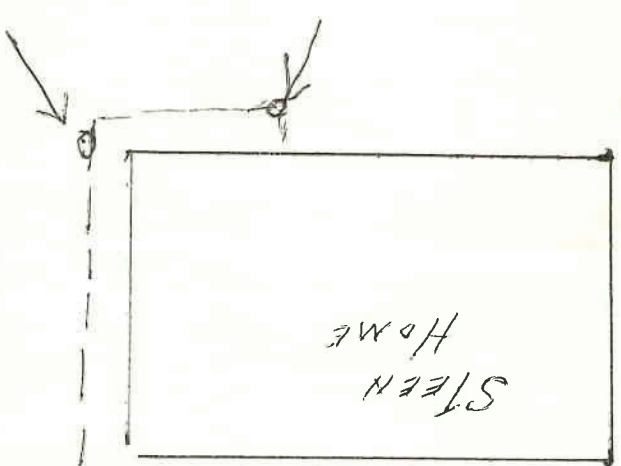

1st CLEAN OUT 5'10\"/>

08-2500.0

- 1. Commercial Single Residence Multiple Dwelling Joint Use
- 2. Distance from property line to sewer line
- 3. Distance from house building line to property line From property line to bldg. 2 1/2'
- 4. Min. grade from main to property line
- 5. Distance from M. H. No.
- 6. Depth: Sewer main Basement connection (Reference to first floor)
- 7. Basement
- 8. Depth of pipe at house connection Vitrified Clay Asbestos-Cement Size 8"
- 9. Type of pipe: Concrete
- 10. Remarks:

COMMERCIAL ONLY

- 1. Name
- 2. Type
- 3. Sq. Ft. Floor Space
- 4. No. of Floors
- 5. Remarks:

SPECIAL AGREEMENTS

- 1. Grade Release
- 2. High Grade Release
- 3. Non-Protesting Agmt.
- 4. Easement
- 5. Permission to Connect
- 6. Special

I hereby certify that the above connection has been made as shown:
 Inspector Henry Spawmer Date 8/29/60
 Date Permit Issued 8/29/60 Permit No. 263