

THE TOWN OF ARLINGTON

SEWER DEPARTMENT


Side Sewer Plat
(PREPARE IN DUPLICATE)

Permit No. 187

1280

Owner's Name William Jackson
 Owner's Mailing Address 718 West Ave.
 Legal Description of Premises lots 1 & 2 Block 17 - Hader City

Address of Property 718 West Ave.
 Side Sewer Contractor Arthur and Sons
 Mailing Address 4608 36th South West Dr

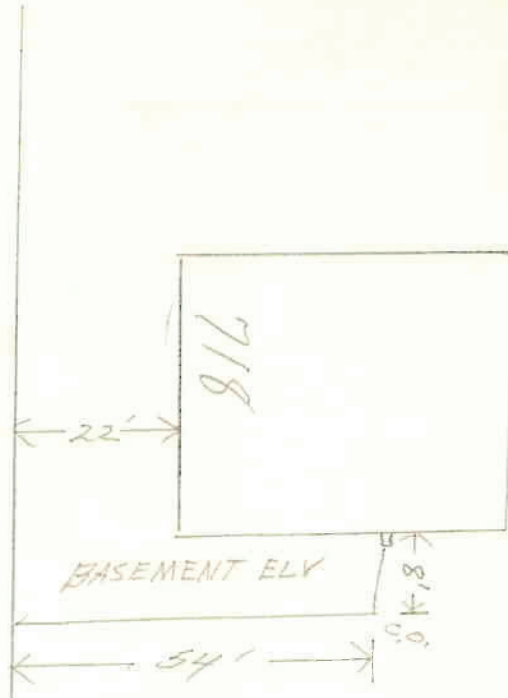

West Ave



02-7500.0

- 1. Commercial..... Single Residence..... Multiple Dwelling..... Joint Use.....
- 2. Distance from property line to sewer line.....
- 3. Distance from house building line to property line..... From property line to bldg. 22'
- 4. Min. Grade from main to property line.....
- 5. Distance from M. H. No.
- 6. Depth: Sewer man.
- 7. Basement..... Basement connection.....
- 8. Depth of pipe at house connection..... (Reference to first floor)
- 9. Type of pipe: Concrete..... Vitrified Clay..... Asbestos-Cement....., Size.....
- 10. Remarks:

COMMERCIAL ONLY		SPECIAL AGREEMENTS	
1. Name		1. Grade Release	
2. Type		2. High Grade Release	
3. Sq. Ft. Floor Space		3. Non-Protecting Agmt.	
4. No. of Floors		4. Easement	
5. Remarks:		5. Permission to Connect	
		6. Special	

I hereby certify that the above connection has been made as shown:

Inspector: Henry Spencer Date: 1/17/60

Date Permit Issued:

Permit No.