


THE TOWN OF ARLINGTON
SEWER DEPARTMENT

Side S, r Plat
(PREPARE IN DUPLICATE)

Permit No. 232

Owner's Name W. J. Dimon
 Owner's Mailing Address 723 Highland Drive
 Legal Description of Premises lots 91+12 Block 3

Address of Property 495 Stillagomish
 Side Sewer Contractor Shawmut 26900
 Mailing Address 4608-36th S. W. Seattle
Shawmut 2nd Odd

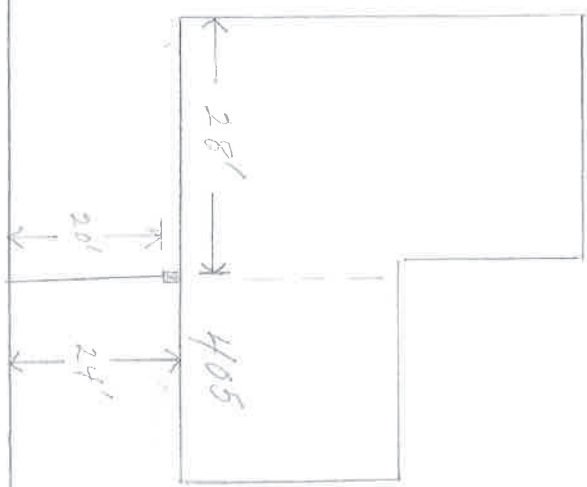

Stillagomish Ave



054100.0

- 1. Commercial Single Residence Multiple Dwelling Joint Use
- 2. Distance from property line to sewer line
- 3. Distance from house building line to property line
- 4. Min. grade from main to property line From property line to bldg. 2.20
- 5. Distance from M. H. No.
- 6. Depth: Sewer main Basement connection
- 7. Basement
- 8. Depth of pipe at house connection (Reference to first floor)
- 9. Type of pipe: Concrete Vitrified Clay Asbestos-Cement Size 8
- 10. Remarks:

COMMERCIAL ONLY		SPECIAL AGREEMENTS	
1. Name		1. Grade Release	
2. Type		2. High Grade Release	
3. Sq. Ft. Floor Space		3. Non-Protecting Agmt.	
4. No. of Floors		4. Easement	
5. Remarks:		5. Permission to Connect	
I hereby certify that the above connection has been made as shown: Inspector: <u>Shawmut</u> Date: <u>1/14/68</u> Date Permit Issued: <u>1/14/68</u> Permit No. <u>232</u>			