ASBUILT

NW 21-31-5

335

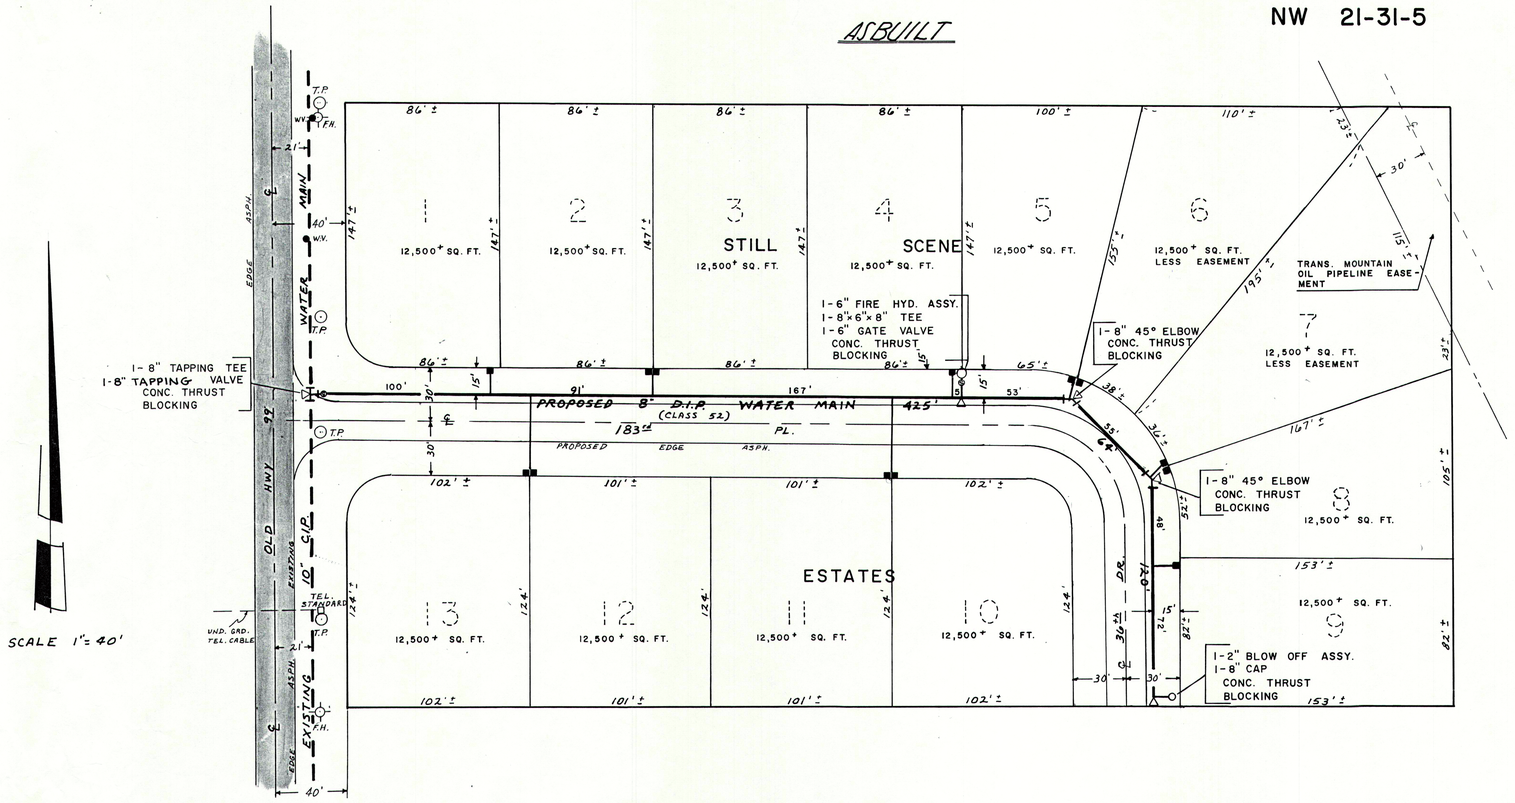

GENERAL NOTES

1. All materials, installation, and workmanship shall conform with A.P.W.A. Specifications, 1977 and City of Marysville, Washington Water Distribution System Specifications For Developer Extensions (hereinafter referred to as Marysville Water Specifications). EXCEPT as hereafter amended and/or supplemented by the City of Marysville.
2. The Contractor shall be responsible for verifying location of existing utilities prior to construction. Utilities shown hereon are for the purpose of assisting the contractor in locating said facilities. No warranty is expressed or implied as to the accuracy or completion of facilities shown.
3. The contractor shall be responsible for obtaining all permits for utility construction.
4. The contractor shall be responsible for maintaining and/or repairing asphalt and gravel surfaces disturbed as a result of this construction until they are accepted by the City Engineer.
5. A minimum of three (3) feet of cover shall be maintained over all mains.
6. Fire hydrants shall have M.V.O. of 5¼ inch, 2-2½ inch hose pe ts, and 1-4 inch pumper port, all threaded to City of Marysville requirements.
7. Back of Meter Boxes shall be one (1) foot from right-of-way line in the public right-of-way.
8. Ductile Iron Pipe shall conform to ANSI Specification A21.51 1976 and/or AWWA C151-76, or latest revision thereof and shall be of the thickness class 52. The pipe shall be furnished with rubber gasketed push-on type joints suitable for use with mechanical joint fittings. Joint details shall be as specified in ANSI A21.11. The pipes shall be coated as specified in ANSI A21.51 and be furnished with cement mortar lining as specified in ANSI A21.4.
9. Testing shall be as set forth by the City of Marysville.
10. Lot lines shown hereon are approximate. Actual platted dimensions and/or deed locations shall take precedence.
11. Double service lines shall be one (1) inch diameter.
Single service lines shall be three-quarter (3/4) inch diameter.
12. Pipe lengths shown are approximate. Contractor is responsible for supplying proper quantities of materials.
13. Blow-off Assembly shall conform with Marysville Water Specifications, "2" Blow-off Assembly - Type 4."
14. Contractor to make wet tap in accordance with 74-2.10 "Connection to Existing Main" of Marysville Water Specifications.
15. Meter boxes to be Skagit Vault Company #1 meter box, or equal, with 4" riser.
16. Water meters to be supplied and installed by City of Marysville.
17. Fire hydrants to conform with,"Type 2 Hydrant Assembly" as specified in Marysville Water Specifications.
18. Contractor shall inform Cascade Surveying & Engineering, Inc. and the City of Marysville upon substantial completion of the system, prior to backfilling, for necessary inspections and approvals.

Examined and approved this 12th day of Sept., 1980.

B Butts
City of Marysville

ASBUILT

DESIGNED G.H. DATE 4/25/80
DRAWN G.H. DATE 6/25/80
CHECKED J.H. DATE 8/12/80
SCALE-HORIZONTAL: 1"= 40'
-VERTICAL:
JOB NUMBER 3021-M
FIELD BOOK
COUNTY SNOHOMISH

REGISTERED PROFESSIONAL ENGINEER STATE OF WASHINGTON ROBERT F. POINTER

Surveying & Engineering, Inc.
MARYSVILLE 659-7654 259-0778
by Cascade Surveying & Engineering, Inc.
ARLINGTON 435-5551 652-7572

for THE N½, NW¼, SW¼, NW¼, SEC 21, T.31N, R.5E. W.M.

STILL SCENE ESTATES

WATER PLAN

PREPARED FOR: POESCHEL AND SCHULTZ, INC.

ASBUILT

123 Sunnyside

1/9

3021-M

SUPERIOR REPROGRAPHICS TB-286