SIDE SEWER INSPECTION FORM

Department of Public Works • Utilities Division
City of Arlington • 154 W. Cox Street • Arlington, WA 98223 • Phone (360) 403-3526

Site Address: 209 S Dunham Avenue
Project Name: Hartman
Permit #: 847
Firm/Developer:
Contact Person:
Contractor: AA Plumbing
Initial Inspection Date: 2/16/2017

Sewer Permit #: 54
Lot #:
Phase:
Inspector: Zach Johnson
Phone:
Phone: 425-489-0123
Final Inspection Date: 2-23-16

Staff Comments:
Side Sewer Repair
All new pvc from city stub to house.
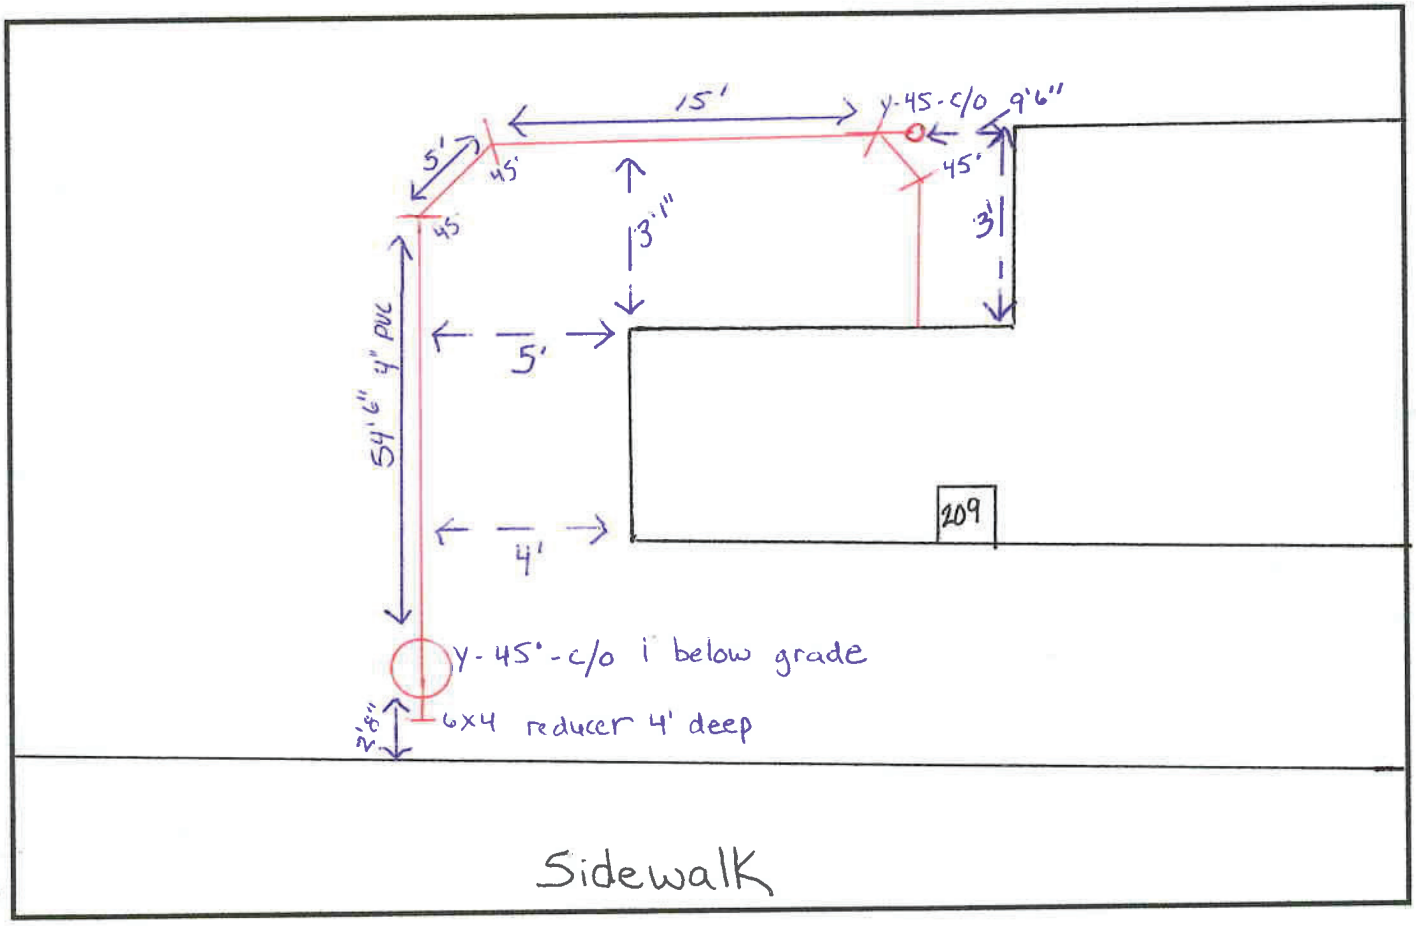
N