THE TOWN OF ARLINGTON
SEWER DEPARTMENT

Side Sewer Plat
(PREPARE IN DUPLICATE)

Permit No. ~~9512~~ 205

Owner's Name John Grove

Owner's Mailing Address 618 West ave

Legal Description of Premises Lots 3 & 4 Block 6

Address of Property

Side Sewer Contractor Paul Weatherud

Mailing Address Apt Box 492 Marysville

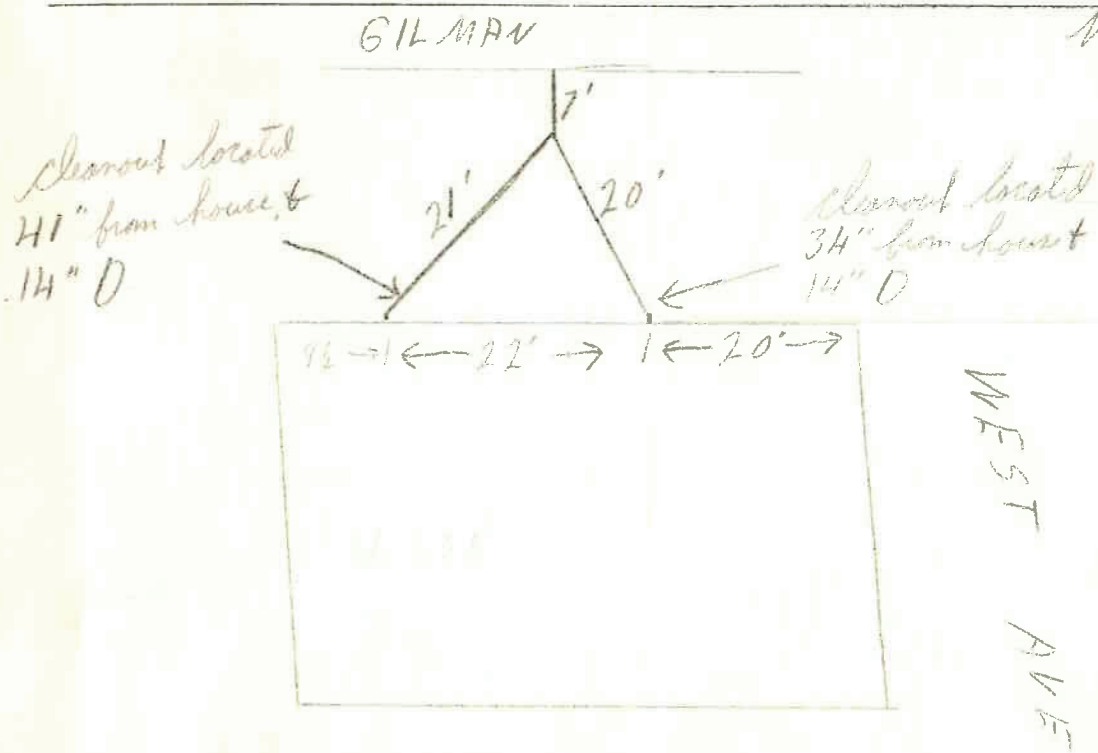

02-7900.0

1. Commercial ..... Single Residence ..... Multiple Dwelling ..... Joint Use .....
2. Distance from property line to sewer line ..... 22' .....
3. Distance from house building line to property line .....
4. Min. grade from main to property line ..... From property line to bldg. 2% .....
5. Distance from M. H. No. 5 .....
6. Depth: Sewer main .....
7. Basement none ..... Basement connection .....
8. Depth of pipe at house connection 12 ..... (Reference to first floor)
9. Type of pipe: Concrete ....., Vitrified Clay ....., Asbestos-Cement ....., Size .....
10. Remarks: This was installed by me on 6-15-59, everything is OK.

COMMERCIAL ONLY

1. Name .....
2. Type .....
3. Sq. Ft. Floor Space .....
4. No. of Floors .....
5. Remarks: .....

SPECIAL AGREEMENTS

1. Grade Release .....
2. High Grade Release .....
3. Non-Protesting Agmt. .....
4. Easement .....
5. Permission to Connect .....
6. Special .....

I hereby certify that the above connection has been made as shown:

Inspector Henry J Deacer Date 11/6/60

Date Permit Issued ..... Permit No. 205